

1 LOCATION OF WATER WELL:	Fraction	Section Number	Township Number	Range Number
County: Butler	SE ¼ SE ¼ NW ¼	3	26	5-East

Distance and direction from nearest town or city street address of well if located within city?

1701 W. Central Street, El Dorado, Kansas2 WATER WELL OWNER: **Town & Country Markets**RR#, St. Address, Box # **P.O. Box 17087**City, State, ZIP Code : **Wichita, Kansas 67217**

Board of Agriculture, Division of Water Resources

Application Number:

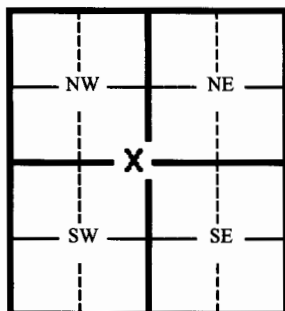
3 MARK WELL'S LOCATION WITH AN "X" IN SECTION BOX:

N

W

E

S

4 DEPTH OF WELL **8.0** ft.WELL'S STATIC WATER LEVEL **Dry** ft.

WELL WAS USED AS:

1 Domestic

2 Irrigation

3 Feedlot

4 Industrial

5 Public Water Supply

6 Oil Field Water Supply

7 Lawn and Garden (domestic)

8 Air Conditioning

9 Dewatering

☒ 10 Monitoring Well

11 Injection Well

12 Other

Was a chemical/bacteriological sample submitted to Department? Yes ___ No **X**

If yes, mo/day/yr sample was submitted

Water Well Disinfected: Yes ___ No **X**

5 TYPE OF BLANK CASING USED:

1 Steel

3 RMP (SR)

5 Wrought

7 Fiberglass

9 Other (specify below)

☒ 2 PVC

4 ABC

6 Asbestos-Cement

8 Concrete Tile

Blank casing diameter **2.375** in.Was casing pulled? Yes **X** No ___If yes, how much? **8.0'**Casing height above or below land surface **Unknown** in.**Overdrilled well to 8.0'**6 GROUT PLUG MATERIAL: 1 Neat cement 2 Cement grout ☒ 3 Bentonite ☒ 4 Other **Soils**Grout Plug Intervals From **8.0** ft. to **3.0** ft. From **3.0** ft. to **0.0** ft. From ___ ft. to ___ ft.

What is the nearest source of possible contamination:

1 Septic tank

6 Seepage pit

☒ 11 Fuel storage (former)

16 Other (specify below)

2 Sewer lines

7 Pit privy

12 Fertilizer storage

3 Watertight sewer lines

8 Sewage lagoon

13 Insecticide storage

4 Lateral lines

9 Feedyard

14 Abandoned water well

5 Cess Pool

10 Livestock pens

15 Oil well/ Gas well

Direction from well? **South** How many feet? **35**

FROM	TO	CODE	PLUGGING MATERIALS
0.0	3.0		Compacted soils
3.0	8.0		Bentonite chips

7 CONTRACTOR'S OR LANDOWNER'S CERTIFICATION: This water well was plugged under my jurisdiction and was completed on (mo/day/yr) **10/17/06** and this record is true to the best of my knowledge and belief. Kansas Water Well Contractor's License No. **692** This Water Well Record was completed on (mo/day/yr) **10/30/06** under the business name of **Quad State Services, Inc.** by (signature) *[Signature]*

INSTRUCTIONS: Please fill in blanks and circle the correct answers. Send three copies to Kansas Department of Health and Environment, Bureau of Water, 1000 S W Jackson St., Ste. 420, Topeka, Kansas 66620-0001. Telephone: 785-296-3565. Send one to Water Well Owner and retain one for your records.