

**CORRECTION(S) TO WATER WELL RECORD (WWC-5)**  
(to rectify lacking or incorrect information)

Location listed as:

Section-Township-Range: 26 - 10 - 5 E

Fraction ( 1/4 1/4 1/4): SE SE NW

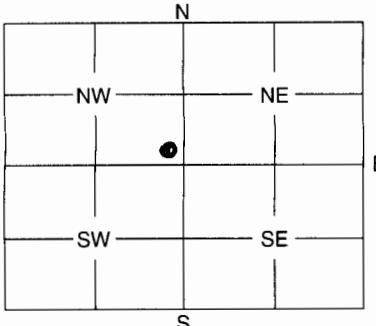
Other changes: Initial statements: \_\_\_\_\_

Changed to: \_\_\_\_\_

Comments: \_\_\_\_\_

verification method: Well owner's address, area road map, legal description, latitude & longitude, & mapping tool on KGS website. initials: DR date: 8/3/2007

submitted by: Kansas Geological Survey, Data Resources Library, 1930 Constant Ave., Lawrence, KS 66047-3726  
to: Kansas Dept of Health & Environment, Bureau of Water, 1000 SW Jackson, Suite 420, Topeka, KS 66612-1367.

1	LOCATION OF WATER WELL:	Fraction	Section Number	Township Number	Range Number																								
County: <i>Butler</i>		<i>SE<sub>1/4</sub> SE<sub>1/4</sub> NW<sub>1/4</sub></i>	<i>26</i>	<i>10</i>	<i>5</i>																								
Distance and direction from nearest town or city street address of well if located within city? <i>Lat N 37 48 244 Long W 096 52 321</i>																													
2	WATER WELL OWNER:	<i>Valero LP 1624 Sunset Rd. Eldorado, Ks.</i>																											
RR #, St. Address, Box #: City, State, ZIP Code :		Board of Agriculture, Division of Water Resources Application Number:																											
3	MARK WELL'S LOCATION WITH AN "X" IN SECTION BOX:	4 DEPTH OF WELL <i>32.50'</i> ft. WELL'S STATIC WATER LEVEL <i>4.29'</i> ft. WELL WAS USED AS: <table> <tr><td>1 Domestic</td><td>5 Public Water Supply</td><td>9 Dewatering</td></tr> <tr><td>2 Irrigation</td><td>6 Oil Field Water Supply</td><td>10 Monitoring Well</td></tr> <tr><td>3 Feedlot</td><td>7 Domestic (Lawn &amp; Garden)</td><td>11 Injection Well</td></tr> <tr><td>4 Industrial</td><td>8 Air Conditioning</td><td>12 Other .....</td></tr> </table>				1 Domestic	5 Public Water Supply	9 Dewatering	2 Irrigation	6 Oil Field Water Supply	10 Monitoring Well	3 Feedlot	7 Domestic (Lawn & Garden)	11 Injection Well	4 Industrial	8 Air Conditioning	12 Other .....												
1 Domestic	5 Public Water Supply	9 Dewatering																											
2 Irrigation	6 Oil Field Water Supply	10 Monitoring Well																											
3 Feedlot	7 Domestic (Lawn & Garden)	11 Injection Well																											
4 Industrial	8 Air Conditioning	12 Other .....																											
 Was a chemical / bacteriological sample submitted to Department? Yes ..... No <input checked="" type="checkbox"/> If yes, mo/day/yr sample was submitted ..... Water Well Disinfected: Yes ..... No <input checked="" type="checkbox"/>																													
5	TYPE OF BLANK CASING USED:																												
<input checked="" type="radio"/> 1 Steel      3 RMP (SR)      5 Wrought      7 Fiberglass      9 Other (Specify below) <input type="radio"/> 2 PVC      4 ABS      6 Asbestos-Cement      8 Concrete Tile																													
Blank casing diameter <i>4.5</i> in.		Was casing pulled?		Yes ..... No <input checked="" type="checkbox"/> If yes, how much <i>Top 3ft.</i>																									
Casing height above or below land surface <i>3ft Below</i> in.																													
6	GROUT PLUG MATERIAL:																												
Grout Plug Intervals: <i>32.50'</i> ft. to <i>4'</i> ft. 1 Neat cement      2 Cement grout      3 Bentonite      4 Other <i>Cement</i> <i>Clay</i> , From <i>4'</i> ft. to <i>2 1/2</i> ft., From <i>2 1/2</i> ft. to <i>0'</i> ft.																													
What is the nearest source of possible contamination:																													
<table> <tr><td>1 Septic tank</td><td>6 Seepage pit</td><td>11 Fuel storage</td><td>16 Other (specify below)</td></tr> <tr><td>2 Sewer lines</td><td>7 Pit privy</td><td>12 Fertilizer storage</td><td>.....</td></tr> <tr><td>3 Watertight sewer lines</td><td>8 Sewage lagoon</td><td>13 Insecticide storage</td><td>.....</td></tr> <tr><td>4 Lateral lines</td><td>9 Feedyard</td><td>14 Abandoned water well</td><td>.....</td></tr> <tr><td>5 Cess pool</td><td>10 Livestock pens</td><td>15 Oil well/Gas well</td><td>.....</td></tr> </table>						1 Septic tank	6 Seepage pit	11 Fuel storage	16 Other (specify below)	2 Sewer lines	7 Pit privy	12 Fertilizer storage	.....	3 Watertight sewer lines	8 Sewage lagoon	13 Insecticide storage	.....	4 Lateral lines	9 Feedyard	14 Abandoned water well	.....	5 Cess pool	10 Livestock pens	15 Oil well/Gas well	.....				
1 Septic tank	6 Seepage pit	11 Fuel storage	16 Other (specify below)																										
2 Sewer lines	7 Pit privy	12 Fertilizer storage	.....																										
3 Watertight sewer lines	8 Sewage lagoon	13 Insecticide storage	.....																										
4 Lateral lines	9 Feedyard	14 Abandoned water well	.....																										
5 Cess pool	10 Livestock pens	15 Oil well/Gas well	.....																										
Direction from well? <i>West</i> How many feet? <i>110'</i>																													
<table border="1"> <thead> <tr> <th>FROM</th> <th>TO</th> <th>PLUGGING MATERIALS</th> </tr> </thead> <tbody> <tr><td><i>32.50</i></td><td><i>4</i></td><td><i>Bentonite</i></td></tr> <tr><td><i>4</i></td><td><i>2 1/2'</i></td><td><i>Cement</i></td></tr> <tr><td><i>2 1/2'</i></td><td><i>0'</i></td><td><i>Clay</i></td></tr> <tr><td> </td><td> </td><td> </td></tr> <tr><td> </td><td> </td><td> </td></tr> <tr><td> </td><td> </td><td> </td></tr> <tr><td> </td><td> </td><td> </td></tr> </tbody> </table>						FROM	TO	PLUGGING MATERIALS	<i>32.50</i>	<i>4</i>	<i>Bentonite</i>	<i>4</i>	<i>2 1/2'</i>	<i>Cement</i>	<i>2 1/2'</i>	<i>0'</i>	<i>Clay</i>												
FROM	TO	PLUGGING MATERIALS																											
<i>32.50</i>	<i>4</i>	<i>Bentonite</i>																											
<i>4</i>	<i>2 1/2'</i>	<i>Cement</i>																											
<i>2 1/2'</i>	<i>0'</i>	<i>Clay</i>																											
7	CONTRACTOR'S OF LANDOWNER'S CERTIFICATION: This water well was plugged under my jurisdiction and was completed on (mo/day/year) <i>6-14-01</i> and this record is true to the best of my knowledge and belief. Kansas Water Well Contractor's License No. <i>732</i> . This Water Well Record was completed on (mo/day/year) ..... under the business name of <i>GB Environmental</i> by (signature) <i>James Baker</i>																												
INSTRUCTIONS: Use typewriter or ball point pen. Please press firmly and print clearly. Please fill in blanks, underline or circle the correct answers. Send top three copies to Kansas Department of Health and Environment, Bureau of Water, Geology Section, 1000 SW Jackson St., Ste. 420, Topeka, Kansas 66612-1367. Telephone: 785/296-5522. Send one to Water Well Owner and retain one for your records.																													