


--

Check: ☒ White Copy, ☐ Blue Copy, ☐ Pink Copy

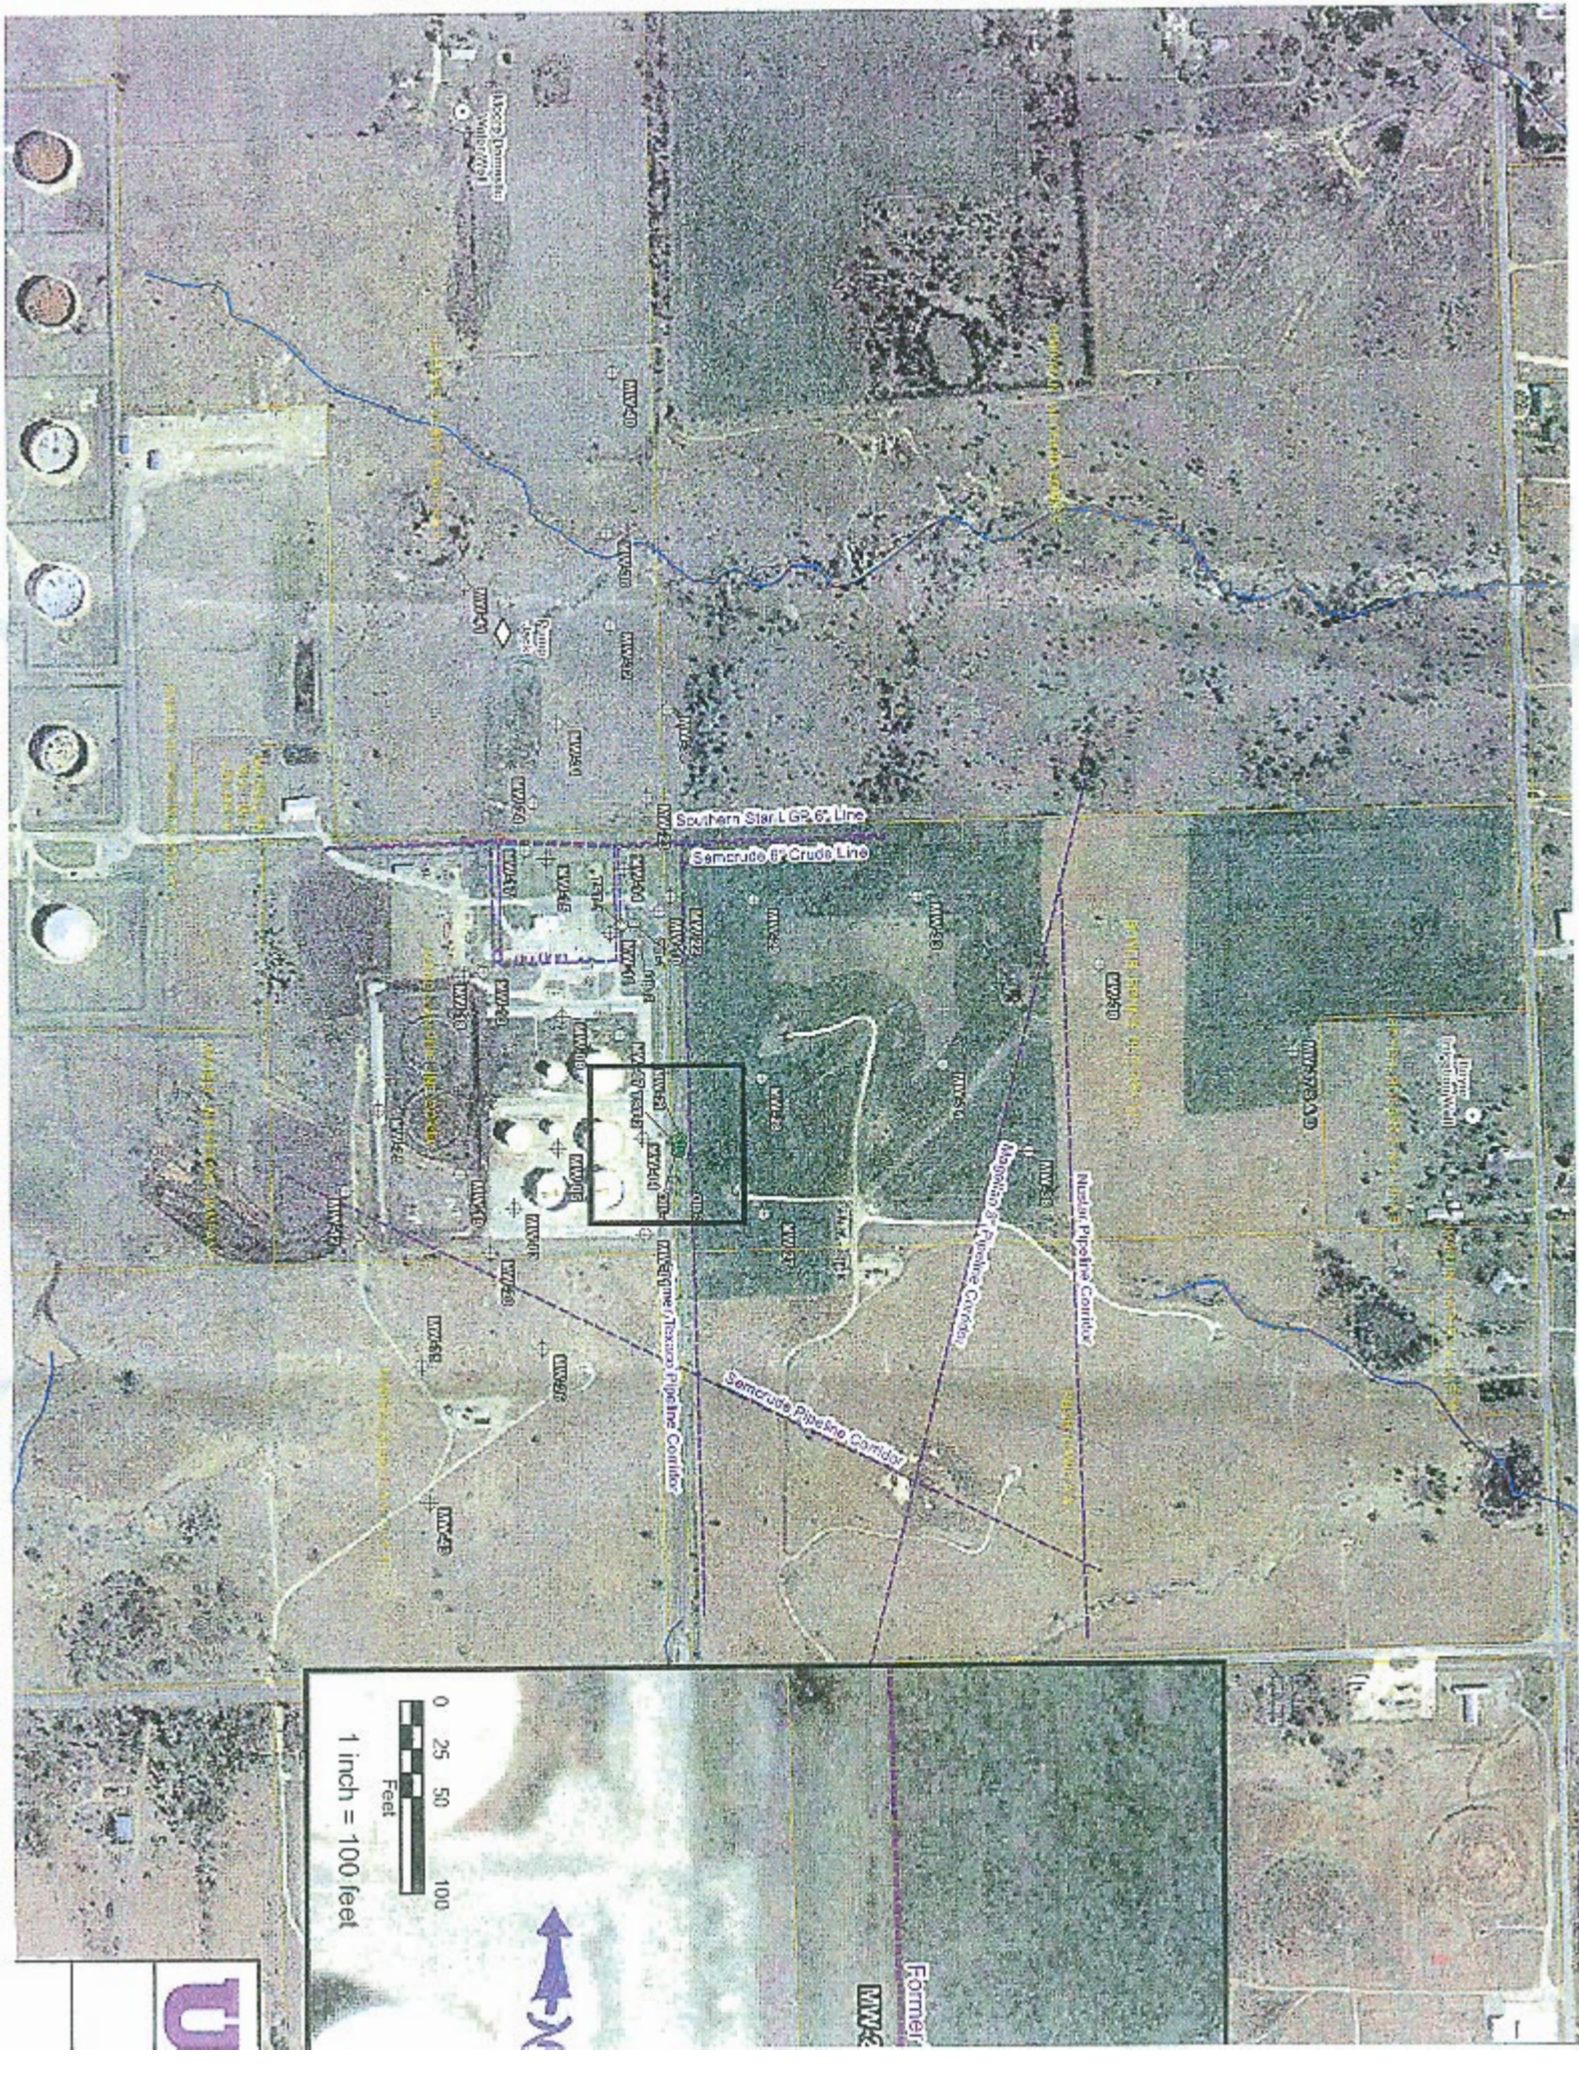

Southern Star LGR 6 Line
Semcrude B Crude Line

Nuclear Pipeline Corridor

Morgantown Pipeline Corridor

Semcrude Pipeline Corridor

0 25 50 100
Feet
1 inch = 100 feet



Former
MV-2