

WATER WELL RECORD

Form WWC-5


Division of Water Resources App. No.

MW-14

1 LOCATION OF WATER WELL: County: Butler, Fraction 1/4 NE 1/4 NE 1/4 SE 1/4, Section Number 3, Township No. T 26 S, Range Number R 5 [X]E []W

Street/Rural Address of Well Location; if unknown, distance & direction from nearest town or intersection: 1631 W. Central Ave. Eldorado, KS. Global Positioning System (GPS) information: Latitude: 37.8170, Longitude: 96.8711, Elevation: , Datum: [X] WGS 84, [] NAD 83, [] NAD 27, Collection Method: [X] GPS unit (Make/Model: Garmin etrex), [] Digital Map/Photo, [] Topographic Map, [] Land Survey, Est. Accuracy: [] <3 m, [X] 3-5 m, [] 5-15 m, [] >15 m

2 WATER WELL OWNER: Phillips 66, RR#, Street Address, Box #: 1614-02 Phillips Blvd., City, State, ZIP Code : Bartlesville, OK 74004

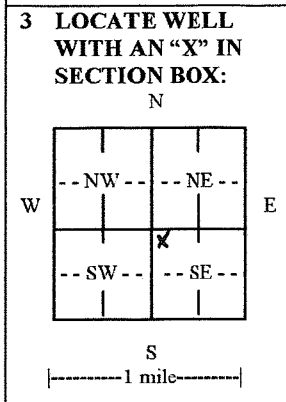

4 DEPTH OF COMPLETED WELL 10 ft. Depth(s) Groundwater Encountered (1)..... ft. (2)..... ft. (3)..... ft. WELL'S STATIC WATER LEVEL..... ft. below land surface measured on mo/day/yr..... Pump test data: Well water was ft. after hours pumping gpm EST. YIELD gpm. Well water was ft. after hours pumping gpm Bore Hole Diameter 8..... in. to 11..... ft., and in. to ft. WELL WATER TO BE USED AS: [] Public water supply [] Geothermal [] Injection well [] Domestic [] Feedlot [] Oil field water supply [] Dewatering [] Other (Specify below) [] Irrigation [] Industrial [] Domestic-lawn & garden [X] Monitoring well Was a chemical/bacteriological sample submitted to Department? [] Yes [X] No If yes, mo/day/yr sample was submitted..... Water well disinfected? [] Yes [X] No

5 TYPE OF CASING USED: [] Steel [X] PVC [] Other CASING JOINTS: [] Glued [] Clamped [] Welded [X] Threaded Casing diameter 2..... in. to 5..... ft., Diameter in. to ft., Diameter in. to ft. Casing height above land surface Flush..... in., Weight lbs./ft., Wall thickness or gauge No. Sch. 40 TYPE OF SCREEN OR PERFORATION MATERIAL: [] Steel [] Stainless Steel [X] PVC [] Other (Specify) [] Brass [] Galvanized Steel [] None used (open hole) SCREEN OR PERFORATION OPENINGS ARE: [] Continuous slot [X] Mill slot [] Gauze wrapped [] Torch cut [] Drilled holes [] None (open hole) [] Louvered shutter [] Key punched [] Wire wrapped [] Saw cut [] Other (specify) SCREEN-PERFORATED INTERVALS: From 10..... ft. to 5..... ft., From ft. to ft., From ft. to ft. GRAVEL PACK INTERVALS: From 10..... ft. to 4..... ft., From ft. to ft., From ft. to ft.

6 GROUT MATERIAL: [] Neat cement [] Cement grout [X] Bentonite [] Other Grout Intervals: From 4..... ft. to 2..... ft., From ft. to ft., From ft. to ft. What is the nearest source of possible contamination: [] Septic tank [] Lateral lines [] Pit privy [] Livestock pens [] Insecticide storage [] Other (specify below) [] Sewer lines [] Cesspool [] Sewage lagoon [X] Fuel storage [] Abandoned water well [] Watertight sewer lines [] Seepage pit [] Feedyard [] Fertilizer storage [] Oil well/gas well Direction from well Distance from well

Table with 6 columns: FROM, TO, LITHOLOGIC LOG, FROM, TO, LITHO. LOG (cont.) or PLUGGING INTERVALS. Rows contain data for Silty Clay, Limestone fragments, and Sandy Clay.

7 CONTRACTOR'S OR LANDOWNER'S CERTIFICATION: This water well was [X] constructed, [] reconstructed, or [] plugged under my jurisdiction and was completed on (mo/day/year) 3/5/2014 and this record is true to the best of my knowledge and belief. Kansas Water Well Contractor's License No. 710..... This Water Well Record was completed on (mo/day/year) 3/17/2014 under the business name of Below Ground Surface, Inc by (signature) [Signature]

INSTRUCTIONS: Use typewriter or ball point pen. PLEASE PRESS FIRMLY and PRINT clearly. Please fill in blanks and check the correct answers. Send three copies (white, blue, pink) to Kansas Department of Health and Environment, Bureau of Water, Geology Section, 1000 SW Jackson St., Suite 420, Topeka, Kansas 66612-1367.