

## WATER WELL PLUGGING RECORD Form WWC-5P

KSA 82a-1212

ID NO.

MW7

1 LOCATION OF WATER WELL: County: <b>Butler</b>	Fraction <b>¼ SE ¼ SE ¼ NW ¼</b>	Section Number <b>3</b>	Township Number <b>T 26 S</b>	Range Number <b>5</b> <input checked="" type="checkbox"/> E <input type="checkbox"/> W
--	-------------------------------------	----------------------------	----------------------------------	---

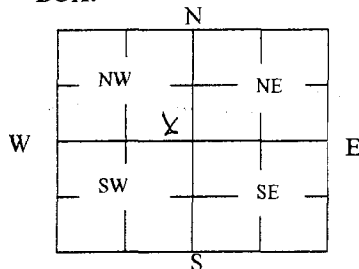
Street/Rural Address of Well Location; if unknown, distance & direction from nearest town or intersection: If at owner's address, check here ☐ ~25' E of 1702 W. Central, El Dorado, KS 67042

## Global Positioning Systems (GPS) information:

Latitude: **NA** (in decimal degrees)Longitude: **NA** (in decimal degrees)Elevation: **NA**Horizontal Datum: ☐ WGS84, ☐ NAD83, ☐ NAD27  
Collection Method:☐ GPS unit (Make/Model):☐ Digital Map/Photo, ☐ Topographic Map, ☐ Land SurveyEst. Accuracy: ☐ < 3 m, ☐ 3-5 m, ☐ 5-15 m, ☐ > 15 m

2 WATER WELL OWNER: Town & Country  
RR#, St. Address, Box #: 1702 W. Central  
City, State ZIP Code: El Dorado, KS 67042

## 3 MARK WELL'S LOCATION WITH AN "X" IN SECTION BOX:

4 DEPTH OF WELL **8.11** ft.WELL'S STATIC WATER LEVEL **NA** ft

WELL WAS USED AS:

☐ Domestic  
☐ Irrigation  
☐ Feedlot  
☐ Industrial

☐ Public Water Supply  
☐ Oil Field Water Supply  
☐ Domestic (Lawn & Garden)  
☐ Air Conditioning

☐ Dewatering  
☒ Monitoring  
☐ Injection Well  
☐ Other
Was a chemical/bacteriological sample submitted to Department? Yes ☐ No ☐

## 5 TYPE OF BLANK CASING USED:

☐ Steel  
☒ PVC☐ RMP (SR)  
☐ ABS☐ Wrought  
☐ Asbestos-Cement☐ Fiberglass  
☐ Concrete Tile☐ Other (Specify below)

Blank casing diameter **2** in. Was casing pulled? Yes ☒ No ☐ If yes, how much **8.11'**  
Casing height above or below land surface **NA** in.

## 6 GROUT PLUG MATERIAL:

☐ Neat cement☐ Cement grout☒ Bentonite☒ Other **Soil:0-1'**Grout Plug Intervals: From **1** ft. to **8.11** ft., From \_\_\_\_\_ ft. to \_\_\_\_\_ ft., From \_\_\_\_\_ ft. to \_\_\_\_\_ ft.

What is the nearest source of possible contamination:

☐ Septic tank  
☐ Sewer lines  
☐ Watertight sewer lines  
☐ Lateral lines  
☐ Cess pool

☐ Seepage pit  
☐ Pit privy  
☐ Sewage lagoon  
☐ Feedyard  
☐ Livestock pens

☒ Fuel storage  
☐ Fertilizer storage  
☐ Insecticide storage  
☐ Abandoned water well  
☐ Oil well/Gas well
☐ Other (specify below)

Direction from well? \_\_\_\_\_

How many feet? \_\_\_\_\_

FROM	TO	PLUGGING MATERIALS	FROM	TO	PLUGGING MATERIALS
0	1	Soil			
1	8.11	Bentonite			
					KDHE Site: Town & Country #7;
					U2-008-01189

7 CONTRACTOR'S OR LANDOWNER'S CERTIFICATION: This water well was plugged under my jurisdiction and was completed on (mo/day/year) **9/3/15** and this record is true to the best of my knowledge and belief. Kansas Water Well Contractor's License No. **757**. This Water Well Record was completed on (mo/day/year) **10/19/15** under the business name of **Larsen & Associates, Inc.** by (signature) \_\_\_\_\_

Send one white copy to Kansas Department of Health & Environment, Geology Section, 1000 SW Jackson Street, Ste. 420, Topeka, KS 66612-1367. Send one copy to WATER WELL OWNER and retain one for your records.

Visit us at <http://www.kdheks.gov/waterwell/index.html> Telephone 785-296-5524

KSA82a-1212

Revised 1/20/2015