

## 1 LOCATION OF WATER WELL:

Fraction

SE  $\frac{1}{4}$  NW  $\frac{1}{4}$  SE  $\frac{1}{4}$ 

Section Number

2

Township Number

T 26

S

Range Number

R 5

E/W

County: BUTLER

Distance and direction from nearest town or city street address of well if located within city?  
410' E + 45' S of the center of Olive & Main

## 2 WATER WELL OWNER: LEWIS AND WEST

m w 7


RR#, St. Address, Box #: 400 S. MAIN

Board of Agriculture, Division of Water Resources

City, State, ZIP Code: EL DORADO, KS

Application Number:

## 3 LOCATE WELL'S LOCATION WITH AN "X" IN SECTION BOX:

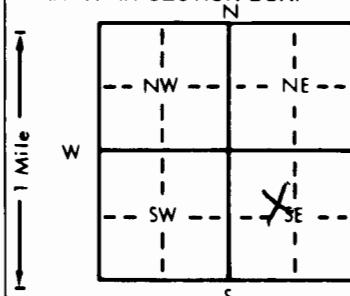

## 4 DEPTH OF COMPLETED WELL: 23 ft. ELEVATION: 75

Depth(s) Groundwater Encountered 1. ft. 2. ft. 3. ft.

WELL'S STATIC WATER LEVEL: 15.78 ft. below land surface measured on mo/day/yr. 12/10/92

Pump test data: Well water was ft. after hours pumping gpm

Est. Yield gpm: Well water was ft. after hours pumping gpm

Bore Hole Diameter in. to ft., and in. to ft.

WELL WATER TO BE USED AS: 5 Public water supply 8 Air conditioning 11 Injection well

1 Domestic 3 Feedlot 6 Oil field water supply 9 Dewatering 12 Other (Specify below)

2 Irrigation 4 Industrial 7 Lawn and garden only 10 Monitoring well

Was a chemical/bacteriological sample submitted to Department? Yes. No. If yes, mo/day sample was submitted

Water Well Disinfected? Yes. No

## 5 TYPE OF BLANK CASING USED:

1 Steel 3 RMP (SR)  
2 PVC 4 ABS

5 Wrought iron 8 Concrete tile Casing joints: Glued Clamped

6 Asbestos-Cement 9 Other (specify below) Welded  
7 Fiberglass Threaded

Blank casing diameter 2 in. to ft. Dia in. to ft. Dia in. to ft.

Casing height above land surface 12 ft. in. weight lbs./ft. Wall thickness or gauge No.

## TYPE OF SCREEN OR PERFORATION MATERIAL:

1 Steel 3 Stainless steel 5 Fiberglass 8 RMP (SR)  
2 Brass 4 Galvanized steel 6 Concrete tile 9 ABS  
1 Continuous slot 3 Mill slot 5 Gauzed wrapped 8 Saw cut 11 None (open hole)  
2 Louvered shutter 4 Key punched 6 Wire wrapped 9 Drilled holes  
7 Torch cut 10 Other (specify)

10 Asbestos-cement

## SCREEN OR PERFORATION OPENINGS ARE:

1 Continuous slot 3 Mill slot  
2 Louvered shutter 4 Key punched

5 Gauzed wrapped

8 Saw cut

11 None (open hole)

6 Wire wrapped  
7 Torch cut

9 Drilled holes

10 Other (specify)

SCREEN-PERFORATED INTERVALS: From 13 ft. to 22 ft. From ft. to ft. From ft. to ft.

From ft. to ft. From ft. to ft. From ft. to ft.

GRAVEL PACK INTERVALS: From 11 ft. to 23 ft. From ft. to ft. From ft. to ft.

From ft. to ft. From ft. to ft. From ft. to ft.

6 GROUT MATERIAL: 1 Neat cement 2 Cement grout 3 Bentonite 4 Other

Grout Intervals: From 0 ft. to 9 ft. From 9 ft. to 11 ft. From 11 ft. to ft.

What is the nearest source of possible contamination: 10 Livestock pens 14 Abandoned water well

1 Septic tank 4 Lateral lines 7 Pit privy 11 Fuel storage 15 Oil well/Gas well  
2 Sewer lines 5 Cess pool 8 Sewage lagoon 12 Fertilizer storage 16 Other (specify below)  
3 Watertight sewer lines 6 Seepage pit 9 Feedyard 13 Insecticide storage 14.5 ft. USTs

Direction from well?

How many feet?

FROM	TO	LITHOLOGIC LOG	FROM	TO	PLUGGING INTERVALS
0	5	CONCRETE			
.5	10	CLAY, BROWN			
10	22	CLAY, SILTY, BROWN			
22	23	CLAY, w/ GRAVEL			