


Well #2W-2

WATER WELL RECORD Form WWC-5 KSA 82a-1212

1 LOCATION OF WATER WELL: County: Butler Fraction SW 1/4 NE 1/4 SE 1/4 Section Number 2 Township Number T 26 S Range Number R 5 EW

Distance and direction from nearest town or city street address of well if located within city? 300 S. Griffith, El Dorado, KS 250' East

2 WATER WELL OWNER: City of El Dorado, KS RR#, St. Address, Box #: 220 East First Street Board of Agriculture, Division of Water Resources City, State, ZIP Code: El Dorado, KS 67042 Application Number:

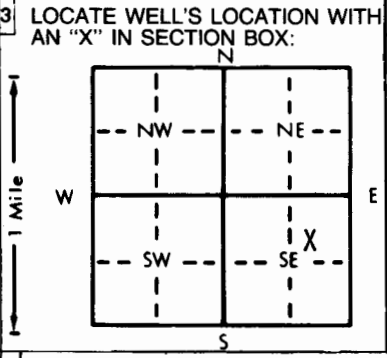

3 LOCATE WELL'S LOCATION WITH AN 'X' IN SECTION BOX: 4 DEPTH OF COMPLETED WELL: 18.8 ft. ELEVATION: Surface 1266.3 ft. WELL'S STATIC WATER LEVEL: 3 ft. below land surface measured on mo/day/yr 8-14-85

5 TYPE OF BLANK CASING USED: 1 Steel, 2 PVC, 3 RMP (SR), 4 ABS, 5 Wrought iron, 6 Asbestos-Cement, 7 Fiberglass, 8 Concrete tile, 9 Other (specify below), CASING JOINTS: Glued, Clamped, Welded, Threaded. TYPE OF SCREEN OR PERFORATION MATERIAL: 1 Steel, 2 Brass, 3 Stainless steel, 4 Galvanized steel, 5 Fiberglass, 6 Concrete tile, 7 PVC, 8 RMP (SR), 9 ABS, 10 Asbestos-cement, 11 Other (specify), 12 None used (open hole). SCREEN OR PERFORATION OPENINGS ARE: 1 Continuous slot, 2 Louvered shutter, 3 Mill slot, 4 Key punched, 5 Gauzed wrapped, 6 Wire wrapped, 7 Torch cut, 8 Saw cut, 9 Drilled holes, 11 None (open hole), 12 Other (specify). SCREEN-PERFORATED INTERVALS: From 8.3 ft. to 18.8 ft. GRAVEL PACK INTERVALS: From 6 ft. to 19.1 ft.

6 GROUT MATERIAL: 1 Neat cement, 2 Cement grout, 3 Bentonite, 4 Other. Grout Intervals: From 0 ft. to 4 ft., From 4 ft. to 6 ft., From 6 ft. to 10 ft. What is the nearest source of possible contamination: 1 Septic tank, 2 Sewer lines, 3 Watertight sewer lines, 4 Lateral lines, 5 Cess pool, 6 Seepage pit, 7 Pit privy, 8 Sewage lagoon, 9 Feedyard, 10 Livestock pens, 11 Fuel storage, 12 Fertilizer storage, 13 Insecticide storage, 14 Abandoned water well, 15 Oil well/Gas well, 16 Other (specify below) Landfill. Direction from well? North How many feet? 5'

LITHOLOGIC LOG table with columns FROM, TO, and LITHOLOGIC LOG. Entries include Silty Clay (0-9), Silty Clay with Gravel (9-16.5), and Gravel changing to Apparent Limestone (16.5-19.1).

7 CONTRACTOR'S OR LANDOWNER'S CERTIFICATION: This water well was (1) constructed, (2) reconstructed, or (3) plugged under my jurisdiction and was completed on (mo/day/year) 7-31-85 and this record is true to the best of my knowledge and belief. Kansas Water Well Contractor's License No. 416 This Water Well Record was completed on (mo/day/yr) 10-23-85 under the business name of TERRACON CONSULTANTS INC. by (signature) [Signature]

INSTRUCTIONS: Use typewriter or ball point pen, PLEASE PRESS FIRMLY and PRINT clearly. Please fill in blanks, underline or circle the correct answers. Send top three copies to Kansas Department of Health and Environment, Division of Environment, Environmental Geology Section, Topeka, KS 66620. Send one to WATER WELL OWNER and retain one for your records.