


1 LOCATION OF WATER WELL:	Fraction	Section Number	Township Number	Range Number
County: Butler	NE ¼ NW ¼ NE ¼	2	T 26 S	R 5 E W

Distance and direction from nearest town or city street address of well if located within city?

425' N of the Center Line of 4th Ave. and 155' E of the Center Line of Main St., El Dorado, KS

2	WATER WELL OWNER:	W.H.T. Real Estate Limited Partnership	01948501	MW-5
	RR#, St. Address, Box # :	600 Las Colinas Boulevard, Suite 1900	Board of Agriculture, Division of Water Resources	
	City, State, ZIP Code :	Irving, Texas 75039	Application Number:	

3	LOCATE WELL'S LOCATION WITH AN "X" IN SECTION BOX:	4	DEPTH OF COMPLETED WELL: 20.5	ft.	ELEVATION: Approx. Surface 1293.8
---	--	---	-------------------------------	-----	-----------------------------------

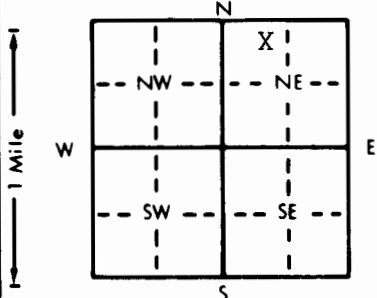

4 DEPTH OF COMPLETED WELL..... 20.5 ft. ELEVATION: .. Approx. Surface 1293.8
Depth(s) Groundwater Encountered 1. 18 ft. 2. ft. 3. ft.
WELL'S STATIC WATER LEVEL 18.0 ft. below land surface measured on mo/day/yr 04/21/94

Pump test data: Well water was ft. after hours pumping gpm
 Est. Yield N/A gpm: Well water was ft. after hours pumping gpm
 Bore Hole Diameter 10.5 in. to 20.5 ft., and in. to ft.

WELL WATER TO BE USED AS:

1 Domestic	3 Feedlot	6 Oil field water supply	9 Dewatering	12 Other (Specify below)
2 Irrigation	4 Industrial	7 Lawn and garden only	<u>10</u> Monitoring well	

Was a chemical/bacteriological sample submitted to Department? Yes.....No.....X.....; If yes, mo/day/yr sample was submitted

Water Well Disinfected? Yes No X

5 TYPE OF BLANK CASING USED:		5 Wrought iron	8 Concrete tile	CASING JOINTS: Glued Clamped	
1 Steel	3 RMP (SR)	6 Asbestos-Cement	9 Other (specify below)	Welded	
② PVC	4 ABS	7 Fiberglass		Threaded. X	
Blank casing diameter 4 in. to 10.5 ft.		Dia in. to ft.		Dia in. to ft.	
Casing height above land surface -3 in.		weight lbs./ft.		Wall thickness or gauge No. Schedule 40	

TYPE OF SCREEN OR PERFORATION MATERIAL:			⑦ PVC	10 Asbestos-cement
1 Steel	3 Stainless steel	5 Fiberglass	8 RMP (SR)	11 Other (specify)
2 Brass	4 Galvanized steel	6 Concrete tile	9 ABS	12 None used (open hole)

SCREEN OR PERFORATION OPENINGS ARE:

1 Continuous slot	3 Mill slot	5 Gauzed wrapped	8 Saw cut	11 None (open hole)
2 Louvered shutter	4 Key punched	6 Wire wrapped	9 Drilled holes	
		7 Torch cut	10 Other (specify)	

SCREEN-PERFORATED INTERVALS:	From	10.5	ft. to	20.5	ft., From		ft. to		ft.
	From		ft. to		ft., From		ft. to		ft.
GRAVEL PACK INTERVALS:	From	10.5	ft. to	20.5	ft., From		ft. to		ft.
	From		ft. to		ft., From		ft. to		ft.

6 GROUT MATERIAL: ① Neat cement 2 Cement grout ③ Bentonite 4 Other
Grout Intervals: From 0 ft. to 9 ft. From 9 ft. to 10.5 ft. From . ft. to . ft.

What is the nearest source of possible contamination:			10 Livestock pens	14 Abandoned water well
1 Septic tank	4 Lateral lines	7 Pit privy	11 Fuel storage	15 Oil well/Gas well
2 Sewer lines	5 Cess pool	8 Sewage lagoon	12 Fertilizer storage	16 Other (specify below)
3 Watertight sewer lines	6 Seepage pit	9 Feedyard	13 Insecticide storage	

Direction from well? _____ How many feet? _____

[illegible]

7 CONTRACTOR'S OR LANDOWNER'S CERTIFICATION: This water well was (1) constructed, (2) reconstructed, or (3) plugged under my jurisdiction and was completed on (mo/day/year) 04/13/94 and this record is true to the best of my knowledge and belief. Kansas Water Well Contractor's License No. 416 This Water Well Record was completed on (mo/day/yr) 4-26-94 under the business name of Terracon Consultants, Inc. by (signature) Steve Fischer