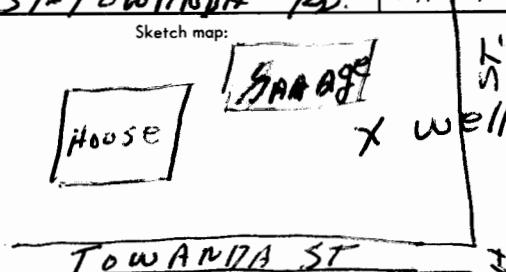


USE TYPEWRITER OR BALL
POINT PEN-PRESS FIRMLY,
PRINT CLEARLY.

WATER WELL RECORD
KSA 82a-1201-1215

Kansas Department of Health and
Environment-Division of Environment
(Water well Contractors)
Topeka, Kansas 66620

1. Location of well:	County Botkin	Fraction SE 1/4 SE 1/4 SE 1/4	Section number 3	Township number T 26	Range number S R 5
2. Distance and direction from nearest town or city:			3. Owner of well: D. A. BALL		
Street address of well location if in city: 1030 WEST-TOWANDA Ks.	R.R. or street: EL DORADO		City, state, zip code: EL DORADO/KANSAS 67042		
4. Locate with "X" in section below:	Sketch map: 		6. Bore hole dia. 10 in. Completion date 5-23-81 Well depth 131 ft.		
			7. <input checked="" type="checkbox"/> Cable tool <input type="checkbox"/> Rotary <input type="checkbox"/> Driven <input type="checkbox"/> Dug <input type="checkbox"/> Hollow rod <input type="checkbox"/> Jetted <input type="checkbox"/> Bored <input type="checkbox"/> Reverse rotary		
			8. Use: <input type="checkbox"/> Domestic <input type="checkbox"/> Public supply <input type="checkbox"/> Industry <input type="checkbox"/> Irrigation <input type="checkbox"/> Air conditioning <input type="checkbox"/> Stock <input checked="" type="checkbox"/> Lawn <input type="checkbox"/> Oil field water <input type="checkbox"/> Other		
			9. Casing: Material <input type="checkbox"/> Threaded <input checked="" type="checkbox"/> Welded <input type="checkbox"/> Surface 24" in. RMP PVC Weight lbs./ft. Dia. 5 in. to 131 ft. depth Wall Thickness: inches or Dia. 5 in. to 131 ft. depth gage No. 300+40		
5. Type and color of material			From 0	To 2	10. Screen: Manufacturer's name ASTM Type PVC Dia. 5" Slot/gauze 1/6 Length 29 ft Set between 111 ft. and 131 ft. ft. and ft. Gravel pack? <input checked="" type="checkbox"/> Size range of material 1/8-1/4
TOPSOIL					
Red CLAY "hill gravel"			2	6	
Lime Brown			6	12	
Lime			12	42	
SHALE gray			42	50	
Lime - chert			50	122	
SHALE gray			122	131	
(Use a second sheet if needed)					
18. Elevation:	19. Remarks:				
Topography: <input checked="" type="checkbox"/> Hill <input type="checkbox"/> Slope <input type="checkbox"/> Upland <input type="checkbox"/> Valley					
20. Water well contractor's certification: This well was drilled under my jurisdiction and this report is true to the best of my knowledge and belief. B+5 DRILLING 335 Business name R#1 EL DORADO KS License No. Address Bart Hoagboom Date 6-1-81 Signed Bart Hoagboom Authorized representative					