

1 LOCATION OF WATER WELL:

County: Butler

Fraction

SW 1/4 SW 1/4 NE 1/4

Section Number

3

Township Number

T-26-S

Range Number

R-5-E

Distance and direction from nearest town or city street address of well if located within city?

122 N. Residence El Dorado, Kansas 67042

2 WATER WELL OWNER:

RR#, St. Address, Box # :

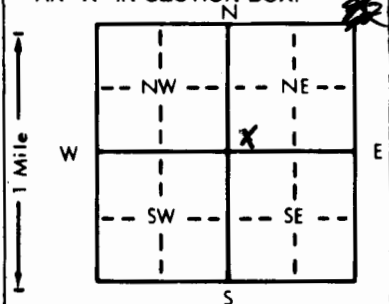
City, State, ZIP Code :

Donald R. May122 N. ResidenceEl Dorado, Kansas 67042Houts Addition East 10' of Lot 1 All of Block 1

Board of Agriculture, Division of Water Resources

Application Number:

3 LOCATE WELL'S LOCATION WITH AN "X" IN SECTION BOX:

4 DEPTH OF COMPLETED WELL: 55' ft. ELEVATION:Depth(s) Groundwater Encountered 1. 40' ft. 2. 55' ft. 3. 55' ft.WELL'S STATIC WATER LEVEL 26' ft. below land surface measured on mo/day/yr 5/7/81Pump test data: Well water was 80 gpm; 

WELL WATER TO BE USED AS: 5 Public water supply 8 Air conditioning 11 Injection well

① Domestic 3 Feedlot 6 Oil field water supply 9 Dewatering 12 Other (Specify below)

2 Irrigation 4 Industrial 7 Lawn and garden only 10 Observation well

Was a chemical/bacteriological sample submitted to Department? Yes X No X; If yes, mo/day/yr sample was submittedWater Well Disinfected? Yes X No X

5 TYPE OF BLANK CASING USED:

1 Steel

3 RMP (SR)

5 Wrought iron

8 Concrete tile

CASING JOINTS: Glued X Clamped X

② PVC

4 ABS

6 Asbestos-Cement

9 Other (specify below)

Welded X

7 Fiberglass

Threaded XBlank casing diameter 8" in. to 55' ft., Dia. 160 in. to 55' ft., Dia. 160 in. to 55' ft.Casing height above land surface 24" in., weight 160 lbs./ft. Wall thickness or gauge No. SDR 26

TYPE OF SCREEN OR PERFORATION MATERIAL:

1 Steel

3 Stainless steel

5 Fiberglass

⑦ PVC

10 Asbestos-cement

2 Brass

4 Galvanized steel

6 Concrete tile

8 RMP (SR)

11 Other (specify)

9 ABS

12 None used (open hole)

SCREEN OR PERFORATION OPENINGS ARE:

1 Continuous slot

3 Mill slot

5 Gauzed wrapped

8 Saw cut

11 None (open hole)

2 Louvered shutter

4 Key punched

6 Wire wrapped

⑨ Drilled holes

7 Torch cut

10 Other (specify)


6 GROUT MATERIAL:

① Neat cement

2 Cement grout

3 Bentonite

4 Other

Grout Intervals: From 4 ft. to 15 ft., From 4 ft. to 15 ft., From 4 ft. to 15 ft.

What is the nearest source of possible contamination:

1 Septic tank

4 Lateral lines

7 Pit privy

10 Livestock pens

14 Abandoned water well

2 Sewer lines

5 Cess pool

8 Sewage lagoon

11 Fuel storage

15 Oil well/Gas well

③ Watertight sewer lines

6 Seepage pit

9 Feedyard

12 Fertilizer storage

16 Other (specify below)

13 Insecticide storage

Direction from well? EASTHow many feet? 20'

FROM	TO	LITHOLOGIC LOG	FROM	TO	LITHOLOGIC LOG
0'	2'	Soil			
2'	8'	Clay			
8'	20'	Limestone			
20'	30'	Shale			
30'	35'	Limestone			
35'	40'	Shale			
40'	45'	Confined aquifer			
40'	55'	Sandy lime			

7 CONTRACTOR'S OR LANDOWNER'S CERTIFICATION: This water well was (1) constructed (2) reconstructed, or (3) plugged under my jurisdiction and was

completed on (mo/day/year) 5/8/81 and this record is true to the best of my knowledge and belief. KansasWater Well Contractor's License No. 413This Water Well Record was completed on (mo/day/yr) 5/8/81under the business name of Tumble Weed Drillingby (signature) Thomas W. Hoebler

INSTRUCTIONS: Use typewriter or ball point pen, PLEASE PRESS FIRMLY and PRINT clearly. Please fill in blanks, underline or circle the correct answers. Send top three copies to Kansas Department of Health and Environment, Division of Environment, Environmental Geology Section, Topeka, KS 66620. Send one to WATER WELL OWNER and retain one for your records.