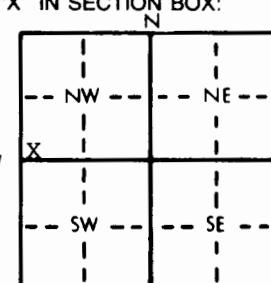
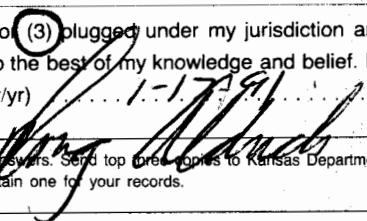


WATER WELL RECORD Form WWC-5 KSA 82a-1212

1 LOCATION OF WATER WELL:		Fraction County: Butler SW 1/4 SW 1/4 NW 1/4	Section Number 4	Township Number T 26 S	Range Number R 5 E/W		
Distance and direction from nearest town or city street address of well if located within city? 180' N of the intersection of Highway 254 and Township Road, El Dorado, KS 52905044 MW-8							
2 WATER WELL OWNER: Phillips Petroleum Company RR#, St. Address, Box #: 411 Keller, 12A2 Phillips Building City, State, ZIP Code: Bartlesville, OK 74004		Board of Agriculture, Division of Water Resources Application Number:					
3 LOCATE WELL'S LOCATION WITH AN "X" IN SECTION BOX: 		4 DEPTH OF COMPLETED WELL: 12 ft. ELEVATION: Approx. Surface Elev.: 1350 Depth(s) Groundwater Encountered: 1. 5 ft. 2. ft. 3. ft. WELL'S STATIC WATER LEVEL: 7.9 ft. below land surface measured on mo/day/yr 06/08/90 Pump test data: Well water was ft. after hours pumping gpm Est. Yield: N/A gpm: Well water was ft. after hours pumping gpm Bore Hole Diameter: 6 in. to 12 ft. and in. to ft. WELL WATER TO BE USED AS: 5 Public water supply 8 Air conditioning 11 Injection well 1 Domestic 3 Feedlot 6 Oil field water supply 9 Dewatering 12 Other (Specify below) 2 Irrigation 4 Industrial 7 Lawn and garden only 10 Monitoring well Was a chemical/bacteriological sample submitted to Department? Yes..... No..... X..... If yes, mo/day/yr sample was submitted Water Well Disinfected? Yes No X					
5 TYPE OF BLANK CASING USED: 1 Steel 3 RMP (SR) 2 PVC 4 ABS		5 Wrought iron 6 Asbestos-Cement 7 Fiberglass	8 Concrete tile 9 Other (specify below)	CASING JOINTS: Glued..... Clamped..... Welded..... Threaded.....			
Blank casing diameter in. to ft., Dia in. to ft., Dia in. to ft.		Casing height above land surface in., weight lbs./ft. Wall thickness or gauge No.					
TYPE OF SCREEN OR PERFORATION MATERIAL: 1 Steel 3 Stainless steel 5 Fiberglass 7 PVC 10 Asbestos-cement 2 Brass 4 Galvanized steel 6 Concrete tile 9 ABS 11 Other (specify) 12 None used (open hole)							
SCREEN OR PERFORATION OPENINGS ARE: 1 Continuous slot 3 Mill slot 5 Gauzed wrapped 8 Saw cut 11 None (open hole) 2 Louvered shutter 4 Key punched 6 Wire wrapped 9 Drilled holes 7 Torch cut 10 Other (specify)							
SCREEN-PERFORATED INTERVALS: From ft. to ft., From ft. to ft., From ft. to ft., From ft. to ft.							
GRAVEL PACK INTERVALS: From ft. to ft., From ft. to ft., From ft. to ft., From ft. to ft.							
6 GROUT MATERIAL: 1 Neat cement 2 Cement grout 3 Bentonite 4 Other Sand..... Grout Intervals: From 12 ft. to 8 ft., From 8 ft. to 3 ft., From ft. to ft., From ft. to ft. What is the nearest source of possible contamination: 1 Septic tank 4 Lateral lines 7 Pit privy 10 Livestock pens 14 Abandoned water well 2 Sewer lines 5 Cess pool 8 Sewage lagoon 11 Fuel storage 15 Oil well/Gas well 3 Watertight sewer lines 6 Seepage pit 9 Feedyard 12 Fertilizer storage 16 Other (specify below) 13 Insecticide storage							
Direction from well? WNW How many feet? 220							
FROM	TO	LITHOLOGIC LOG		FROM	TO	PLUGGING INTERVALS	
				12	8	Sand	
				8	3	Neat Cement	
7 CONTRACTOR'S OR LANDOWNER'S CERTIFICATION: This water well was (1) constructed, (2) reconstructed, or (3) plugged under my jurisdiction and was completed on (mo/day/year) 09/11/90 and this record is true to the best of my knowledge and belief. Kansas Water Well Contractor's License No. 416 This Water Well Record was completed on (mo/day/yr) 1-17-91 under the business name of Terracon Consultants, Inc. by (signature) 							
INSTRUCTIONS: Use typewriter or ball point pen. PLEASE PRESS FIRMLY and PRINT clearly. Please fill in blanks, underline or circle the correct answers. Send top three copies to Kansas Department of Health and Environment, Bureau of Water, Topeka, Kansas 66620-7320. Telephone: 913-296-5545. Send one to WATER WELL OWNER and retain one for your records.							