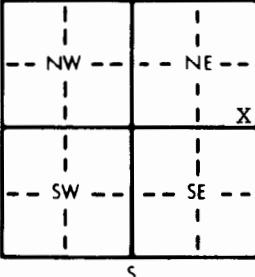
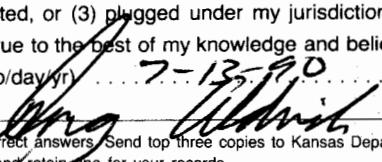


WATER WELL RECORD Form WWC-5 KSA 82a-1212

1 LOCATION OF WATER WELL:		Fraction SE 1/4 SE 1/4 NE 1/4	Section Number 5	Township Number T 26 S	Range Number R 5 E W		
Distance and direction from nearest town or city street address of well if located within city? 240' NW of the intersection of Highway 254 and Township Road, El Dorado, KS MW-4 52905044							
2 WATER WELL OWNER:		Phillips Petroleum Company		Board of Agriculture, Division of Water Resources			
RR#, St. Address, Box #:		411 Keller, 12A2 Phillips Bldg.		Application Number:			
City, State, ZIP Code:		Bartlesville, OK 74004					
3 LOCATE WELL'S LOCATION WITH AN "X" IN SECTION BOX:		<input checked="" type="checkbox"/> 4 DEPTH OF COMPLETED WELL 11.5 ft. ELEVATION: Approx. Surface Elev: 1350 Depth(s) Groundwater Encountered 1 5 ft. 2 ft. 3 ft. WELL'S STATIC WATER LEVEL 4.4 ft. below land surface measured on mo/day/yr 06/08/90 Pump test data: Well water was ft. after hours pumping gpm Est. Yield N/A gpm: Well water was ft. after hours pumping gpm Bore Hole Diameter 6 in. to 12 ft., and in. to ft. WELL WATER TO BE USED AS: 5 Public water supply 8 Air conditioning 11 Injection well 1 Domestic 3 Feedlot 6 Oil field water supply 9 Dewatering 12 Other (Specify below) 2 Irrigation 4 Industrial 7 Lawn and garden only 10 Monitoring well Was a chemical/bacteriological sample submitted to Department? Yes No X If yes, mo/day/yr sample was submitted					
				Water Well Disinfected? Yes X No 			
5 TYPE OF BLANK CASING USED:		5 Wrought iron	8 Concrete tile	CASING JOINTS: Glued Clamped			
1 Steel	3 RMP (SR)	6 Asbestos-Cement	9 Other (specify below)	Welded			
2 PVC	4 ABS	7 Fiberglass		Threaded X			
Blank casing diameter 2 in. to 4 ft., Dia in. to ft., Dia in. to ft.							
Casing height above land surface -6 in., weight lbs./ft. Wall thickness or gauge No. Schedule 40							
TYPE OF SCREEN OR PERFORATION MATERIAL:		7 PVC	10 Asbestos-cement				
1 Steel	3 Stainless steel	5 Fiberglass	8 RMP (SR)	11 Other (specify)			
2 Brass	4 Galvanized steel	6 Concrete tile	9 ABS	12 None used (open hole)			
SCREEN OR PERFORATION OPENINGS ARE:		5 Gauzed wrapped	8 Saw cut	11 None (open hole)			
1 Continuous slot	3 Mill slot	6 Wire wrapped	9 Drilled holes				
2 Louvered shutter	4 Key punched	7 Torch cut	10 Other (specify)				
SCREEN-PERFORATED INTERVALS: From 4.0 ft. to 11.5 ft., From ft. to ft., From ft. to ft.							
GRAVEL PACK INTERVALS: From 3.5 ft. to 12.0 ft., From ft. to ft., From ft. to ft.							
6 GROUT MATERIAL: 1 Neat cement 2 Cement grout		3 Bentonite	4 Other				
Grout Intervals: From 0 ft. to 3.5 ft., From ft. to ft., From ft. to ft.							
What is the nearest source of possible contamination:				10 Livestock pens	14 Abandoned water well		
1 Septic tank	4 Lateral lines	7 Pit privy	11 Fuel storage	15 Oil well/Gas well			
2 Sewer lines	5 Cess pool	8 Sewage lagoon	12 Fertilizer storage	16 Other (specify below)			
3 Watertight sewer lines	6 Seepage pit	9 Feedyard	13 Insecticide storage				
Direction from well? WNW				How many feet? 60			
FROM	TO	LITHOLOGIC LOG		FROM	TO	PLUGGING INTERVALS	
0	5.0	Red-Brown Fat to Lean Clay with Calcareous Material					
5.0	12.0	Tan Weathered Limestone					
7 CONTRACTOR'S OR LANDOWNER'S CERTIFICATION: This water well was 1 constructed, (2) reconstructed, or (3) plugged under my jurisdiction and was completed on (mo/day/year) 06/06/90				and this record is true to the best of my knowledge and belief. Kansas			
Water Well Contractor's License No. 416				This Water Well Record was completed on (mo/day/year) 7-13-90			
under the business name of Terracon Consultants, Inc.				by (signature) 			
INSTRUCTIONS: Use typewriter or ball point pen. PLEASE PRESS FIRMLY and PRINT clearly. Please fill in blanks, underline or circle the correct answers. Send top three copies to Kansas Department of Health and Environment, Bureau of Water, Topeka, Kansas 66620-7320. Telephone: 913-296-5545. Send one to WATER WELL OWNER and retain one for your records.							