

WATER WELL RECORD

Form WWC-5

Division of Water Resources App. No.

Well ID

MW16

Original Record Correction Change in Well Use

1 LOCATION OF WATER WELL: County Butler
2 WELL OWNER: Last Name: Badwey First: Nick
3 LOCATE WELL WITH 'X' IN SECTION BOX:
4 DEPTH OF COMPLETED WELL: 21.9 ft
5 Latitude: 37.81683 Longitude: 96.84690

7 WELL WATER TO BE USED AS:
1 Domestic: Household, Lawn & Garden, Livestock, Irrigation, Feedlot, Industrial
5 Public Water Supply: well ID
6 Dewatering: how many wells?
7 Aquifer Recharge: well ID
8 Monitoring: well ID MW16
9 Environmental Remediation: well ID
10 Oil Field Water Supply: lease
11 Test Hole: well ID
12 Geothermal: How many bores?

Was a chemical/bacteriological sample submitted to KDHE? Yes No
Water well disinfected? Yes No

8 TYPE OF CASING USED: Steel PVC Other
Casing diameter 2 in. to 6.9 ft
TYPE OF SCREEN OR PERFORATION MATERIAL: Steel Stainless Steel Fiberglass PVC
SCREEN OR PERFORATION OPENINGS ARE: Continuous Slot Mill Slot Gauze Wrapped Torch Cut Drilled Holes

9 GROUT MATERIAL: Neat cement Cement grout Bentonite Other Concrete: 0-0.6'
Grout intervals: From 0.6 ft. to 6 ft.

Nearest source of possible contamination:
Septic Tank Lateral Lines Pit Privy Livestock Pens Insecticide Storage
Sewer Lines Cess Pool Sewage Lagoon Fuel Storage Abandoned Water Well
Watertight Sewer Lines Seepage Pit Feedyard Fertilizer Storage Oil Well / Gas Well

Table with 6 columns: 10 FROM, TO, LITHOLOGIC LOG, FROM, TO, LITHO. LOG (cont.) or PLUGGING INTERVALS. Rows include Concrete, Fill material, and Shale.

11 CONTRACTOR'S OR LANDOWNER'S CERTIFICATION: This water well was constructed, reconstructed, or plugged under my jurisdiction and was completed on (mo-day-year) 7/27/16

TRITERRA LAND SERVICES

KGS Copy

P.O. Box 546
Clearwater, Kansas 67026
Cell (316) 648-3617
Fax (620) 584-4371
E-mail: triterrals@yahoo.com


**SURVEYING OF MONITORING WELLS
NORRIS 66
EL DORADO, KANSAS**

The above site is in Section 2, Township 26 South, Range 5 East of the Sixth Principal Meridian, Butler County, Kansas. The Southeast corner of Section 2 was assigned coordinates of 00.00 North and 00.00 West.

The vertical and horizontal control were from the previous survey. A new control point was established as a chiseled 'X' in the center of the sidewalk at the northeast corner of the site.

The Latitude and Longitude were recorded from a GPS unit. The site is located on the 7.5' quad map titled "El Dorado".

ID	NORTH	WEST	LATITUDE	LONGITUDE	ELEVATION
SE CORNER 2-26S-5E	00.00	00.00			
Control Point	2614.54	725.24	37.81729	96.84624	1283.08
MW-14 NE NW NE SE	2513.09	789.22	37.81704	96.84644	RIM 1284.84 TOC 1284.58
MW-15 NE NW NE SE	2514.11	862.26	37.81703	96.84670	RIM 1284.56 TOC 1284.21
MW-16 NE NW NE SE	2446.08	918.38	37.81683	96.84690	RIM 1283.98 TOC 1283.65
MW-17 NE NW NE SE	2543.20	862.20	37.81710	96.84670	RIM 1284.30 TOC 1284.07
MW-18 NE NW NE SE	2603.81	917.94	37.81726	96.84690	RIM 1283.76 TOC 1283.53
MW-19 NE NW NE SE	2601.79	801.85	37.81725	96.84648	RIM 1284.10 TOC 1283.80
MW-20 SE NW NE SE	2298.61	689.62	37.81642	96.84612	RIM 1279.93 TOC 1279.54

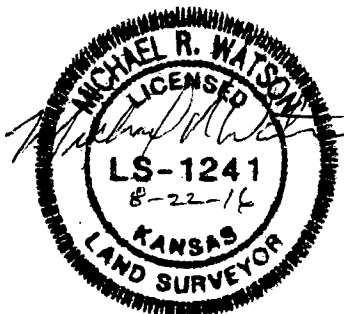

RECEIVED
SEP 19 2016
BUREAU OF WATER