

WATER WELL RECORD

Form WWC-5

Division of Water Resources App. No.

Well ID

MW17

Original Record Correction Change in Well Use

1 LOCATION OF WATER WELL: County Butler Fraction NE 1/4 NW 1/4 NE 1/4 SE 1/4 Section Number 2 Township Number T 26 S Range Number R 5 E W

2 WELL OWNER: Last Name: Badwey First: Nick Street or Rural Address where well is located (if unknown, distance and direction from nearest town or intersection): 301 E. Central, El Dorado, KS

3 LOCATE WELL WITH 'X' IN SECTION BOX: [Diagram] 4 DEPTH OF COMPLETED WELL: 21.98 ft 5 Latitude: 37.81710 Longitude: 96.84670

7 WELL WATER TO BE USED AS: 1 Domestic: Household, Lawn & Garden, Livestock, Irrigation, Feedlot, Industrial

Was a chemical/bacteriological sample submitted to KDHE? Yes No Water well disinfected? Yes No

8 TYPE OF CASING USED: Steel PVC Other CASING JOINTS: Glued Clamped Welded Threaded

9 GROUT MATERIAL: Neat cement Cement grout Bentonite Other Concrete: 0-0.6'

Nearest source of possible contamination: Septic Tank Lateral Lines Pit Privy Livestock Pens Insecticide Storage

Table with columns: FROM, TO, LITHOLOGIC LOG, FROM, TO, LITHO. LOG (cont.) or PLUGGING INTERVALS

Notes: KDHE ID: Norris 66 Service:U2-008-12252

11 CONTRACTOR'S OR LANDOWNER'S CERTIFICATION: This water well was constructed, reconstructed, or plugged under my jurisdiction and was completed on (mo-day-year) 7/27/16

TRITERRA LAND SERVICES

KGS Copy

P.O. Box 546
Clearwater, Kansas 67026
Cell (316) 648-3617
Fax (620) 584-4371
E-mail: triterrals@yahoo.com


SURVEYING OF MONITORING WELLS NORRIS 66 EL DORADO, KANSAS

The above site is in Section 2, Township 26 South, Range 5 East of the Sixth Principal Meridian, Butler County, Kansas. The Southeast corner of Section 2 was assigned coordinates of 00.00 North and 00.00 West.

The vertical and horizontal control were from the previous survey. A new control point was established as a chiseled 'X' in the center of the sidewalk at the northeast corner of the site.

The Latitude and Longitude were recorded from a GPS unit. The site is located on the 7.5' quad map titled "El Dorado".

ID	NORTH	WEST	LATITUDE	LONGITUDE	ELEVATION
SE CORNER 2-26S-5E	00.00	00.00			
Control Point	2614.54	725.24	37.81729	96.84624	1283.08
MW-14 NE NW NE SE	2513.09	789.22	37.81704	96.84644	RIM 1284.84 TOC 1284.58
MW-15 NE NW NE SE	2514.11	862.26	37.81703	96.84670	RIM 1284.56 TOC 1284.21
MW-16 NE NW NE SE	2446.08	918.38	37.81683	96.84690	RIM 1283.98 TOC 1283.65
MW-17 NE NW NE SE	2543.20	862.20	37.81710	96.84670	RIM 1284.30 TOC 1284.07
MW-18 NE NW NE SE	2603.81	917.94	37.81726	96.84690	RIM 1283.76 TOC 1283.53
MW-19 NE NW NE SE	2601.79	801.85	37.81725	96.84648	RIM 1284.10 TOC 1283.80
MW-20 SE NW NE SE	2298.61	689.62	37.81642	96.84612	RIM 1279.93 TOC 1279.54

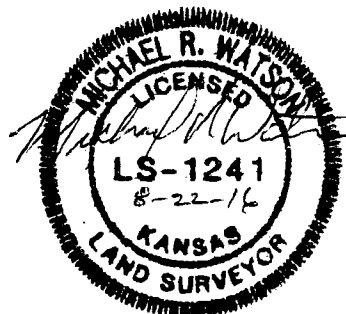

RECEIVED
SEP 19 2016
BUREAU OF WATER