

1 LOCATION OF WATER WELL:

Fraction

County: **BUTLER**S $\frac{1}{4}$ SE $\frac{1}{4}$ NW $\frac{1}{4}$

Section Number

5

Township Number

T 26

Range Number

R 5 EW

Distance and direction from nearest town or city street address of well if located within city?

CHECK POINT LOCATION - EL DORADO2 WATER WELL OWNER: **KANSAS TURNPIKE**

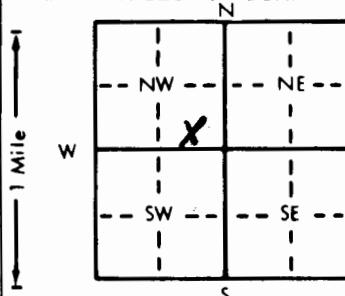
RR#, St. Address, Box # :

Board of Agriculture, Division of Water Resource:

City, State, ZIP Code :

Application Number:

3 LOCATE WELL'S LOCATION WITH AN "X" IN SECTION BOX:

4 DEPTH OF COMPLETED WELL: **12** ft. ELEVATION: **—**

Depth(s) Groundwater Encountered 1. ft. 2. ft. 3. ft.

WELL'S STATIC WATER LEVEL ft. below land surface measured on mo/day/yr

Pump test data: Well water was ft. after hours pumping gpm

Est. Yield gpm. Well water was ft. after hours pumping gpm

Bore Hole Diameter in. to ft. and in. to ft.

WELL WATER TO BE USED AS: 5 Public water supply 8 Air conditioning 11 Injection well

1 Domestic 3 Feedlot 6 Oil field water supply 9 Dewatering 12 Other (Specify below)

2 Irrigation 4 Industrial 7 Lawn and garden only 10 Monitoring well

Was a chemical/bacteriological sample submitted to Department? Yes No If yes, mo/day/yr sample was submittedWater Well Disinfected? Yes No

5 TYPE OF BLANK CASING USED:

1 Steel 3 RMP (SR)
2 PVC 4 ABS

5 Wrought iron

8 Concrete tile

CASING JOINTS: Glued Clamped

6 Asbestos-Cement

9 Other (specify below)

Welded

7 Fiberglass

Threaded

Blank casing diameter in. to ft. Dia in. to ft. Dia in. to ft.

Casing height above land surface in. weight lbs./ft. Wall thickness or gauge No. **Sch 40**

TYPE OF SCREEN OR PERFORATION MATERIAL:

1 Steel 3 Stainless steel
2 Brass 4 Galvanized steel
3 Mill slot
4 Key punched

5 Fiberglass

8 RMP (SR)

10 Asbestos-cement

6 Concrete tile

9 ABS

11 Other (specify)

5 Gauzed wrapped

8 Saw cut

11 None (open hole)

6 Wire wrapped

9 Drilled holes

7 Torch cut

10 Other (specify)

SCREEN-PERFORATED INTERVALS: From. 2 ft. to 12 ft. From. ft. to ft. From. ft. to ft.

GRAVEL PACK INTERVALS: From. 1.5 ft. to 12 ft. From. ft. to ft. From. ft. to ft.

6 GROUT MATERIAL: 1 Neat cement 2 Cement grout 3 Bentonite 4 Other

Grout Intervals: From. 1 ft. to 1.5 ft. From. ft. to ft. From. ft. to ft. From. ft. to ft.

What is the nearest source of possible contamination:

1 Septic tank 4 Lateral lines 7 Pit privy
2 Sewer lines 5 Cess pool 8 Sewage lagoon
3 Watertight sewer lines 6 Seepage pit 9 Feedyard

10 Livestock pens

14 Abandoned water well

11 Fuel storage

15 Oil well/Gas well

12 Fertilizer storage

16 Other (specify below)

13 Insecticide storage

Direction from well?

How many feet?

FROM TO LITHOLOGIC LOG FROM TO PLUGGING INTERVALS

0 1 FILL GRAVEL

1 5.5 DK BR CLAY

5.5 12 Ls, HARD, interbedded Soft

7 CONTRACTOR'S OR LANDOWNER'S CERTIFICATION: This water well was (1) constructed (2) reconstructed, or (3) plugged under my jurisdiction and was completed on (mo/day/year) **11-1-90** and this record is true to the best of my knowledge and belief. KansasWater Well Contractor's License No. **524** This Water Well Record was completed on (mo/day/year) **12-5-90** by (signature) **Richard J. Elg in**under the business name of **ALLIED LAB**

INSTRUCTIONS: Use typewriter or ball point pen. PLEASE PRESS FIRMLY and PRINT clearly. Please fill in blanks, underline or circle the correct answers. Send top three copies to Kansas Department of Health and Environment, Bureau of Water, Topeka, Kansas 66620-7320. Telephone: 913-296-5545. Send one to WATER WELL OWNER and retain one for your records.