

WATER WELL RECORD Form WWC-5 KSA 82a-1212

1 LOCATION OF WATER WELL:	Fraction County: Butler SE 1/4 SE 1/4 NE 1/4	Section Number 5	Township Number T 26 S	Range Number R 5 E/W
---------------------------	--	---------------------	---------------------------	-------------------------

Distance and direction from nearest town or city street address of well if located within city?

260' NNW of the intersection of Highway 254 and Township Road, El Dorado, KS MW-6 52905044

2 WATER WELL OWNER: Phillips Petroleum Company


RR#, St. Address, Box #: 411 Keller, 12A2 Phillips Bldg.

Board of Agriculture, Division of Water Resources

City, State, ZIP Code: Bartlesville, OK 74004

Application Number:

3 LOCATE WELL'S LOCATION WITH AN 'X' IN SECTION BOX:

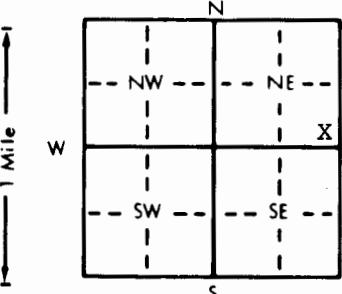

4 DEPTH OF COMPLETED WELL 11.0 . . . ft. ELEVATION Approx. Surface Elev: 1350

Depth(s) Groundwater Encountered 1 5 ft. 2 ft. 3 ft.

WELL'S STATIC WATER LEVEL 4.7 . . . ft. below land surface measured on mo/day/yr 06/08/90 . . .

Pump test data: Well water was ft. after hours pumping gpm

Est. Yield N/A . . . gpm: Well water was ft. after hours pumping gpm

Bore Hole Diameter 6 . . . in. to 11 . . . ft., and in. to ft.

WELL WATER TO BE USED AS: 5 Public water supply 8 Air conditioning 11 Injection well

1 Domestic 3 Feedlot 6 Oil field water supply 9 Dewatering 12 Other (Specify below)

2 Irrigation 4 Industrial 7 Lawn and garden only 10 Monitoring well

Was a chemical/bacteriological sample submitted to Department? Yes No X If yes, mo/day/yr sample was submitted

Water Well Disinfected? Yes No X

5 TYPE OF BLANK CASING USED:

1 Steel 3 RMP (SR)
2 PVC 4 ABS

5 Wrought iron

8 Concrete tile

CASING JOINTS: Glued Clamped

6 Asbestos-Cement
7 Fiberglass

9 Other (specify below)

Welded

Threaded X

Blank casing diameter 2 . . . in. to 3.5 . . . ft., Dia in. to ft., Dia in. to ft.

Casing height above land surface -6 . . . in., weight lbs./ft. Wall thickness or gauge No. Schedule 40

TYPE OF SCREEN OR PERFORATION MATERIAL:

1 Steel 3 Stainless steel
2 Brass 4 Galvanized steel
3 Mill slot
2 Louvered shutter 4 Key punched5 Fiberglass
6 Concrete tile

7 PVC

10 Asbestos-cement

8 RMP (SR)
9 ABS11 Other (specify)
12 None used (open hole)

SCREEN OR PERFORATION OPENINGS ARE:

5 Gauzed wrapped

8 Saw cut

11 None (open hole)

6 Wire wrapped

9 Drilled holes

7 Torch cut

10 Other (specify)

SCREEN-PERFORATED INTERVALS: From 3.5 . . . ft. to 11.0 . . . ft., From ft. to ft.

From ft. to ft., From ft. to ft.

GRAVEL PACK INTERVALS: From 3.0 . . . ft. to 11.0 . . . ft., From ft. to ft.

From ft. to ft., From ft. to ft.

6 GROUT MATERIAL: 1 Neat cement 2 Cement grout 3 Bentonite 4 Other

Grout Intervals: From 0 . . . ft. to 3 . . . ft., From ft. to ft., From ft. to ft.

What is the nearest source of possible contamination:

1 Septic tank 4 Lateral lines
2 Sewer lines 5 Cess pool
3 Watertight sewer lines 6 Seepage pit

10 Livestock pens

14 Abandoned water well

11 Fuel storage

15 Oil well/Gas well

12 Fertilizer storage

16 Other (specify below)

13 Insecticide storage

Direction from well? W

How many feet? 120

FROM TO LITHOLOGIC LOG FROM TO PLUGGING INTERVALS

0 5.0 Red-Brown Fat to Lean Clay with
Calcareous Material

5.0 11.0 Tan Weathered Limestone

7 CONTRACTOR'S OR LANDOWNER'S CERTIFICATION: This water well was (1) constructed, (2) reconstructed, or (3) plugged under my jurisdiction and was completed on (mo/day/year) 06/07/90 and this record is true to the best of my knowledge and belief. Kansas

Water Well Contractor's License No. 416 This Water Well Record was completed on (mo/day/yr) 7-19-90
under the business name of Terracon Consultants, Inc. by (signature)