

1 LOCATION OF WATER WELL 51	Fraction SW 1/4 NE 1/4 SW 1/4	Section Number 13	Township Number T 26 S	Range Number R 5 EW
County: BUTLER	Distance and direction from nearest town or city? SW Corner of Town	Street address of well if located within city? 1401 S. Douglas Rd. El Dorado, Kansas		

2 WATER WELL OWNER: Getty Refining & Marketing Co.	RR#, St. Address, Box #: P. O. Box 1121	Board of Agriculture, Division of Water Resources Application Number: 8.0 1444 95.0		
City, State, ZIP Code: El Dorado, Kansas 67042				

3 DEPTH OF COMPLETED WELL: 45.0 ft. Bore Hole Diameter: 60 in. to 45.0 ft., and 104 in. to 45.0 ft.	Well Water to be used as: 5 Public water supply 8 Air conditioning 11 Injection well	12 Other (Specify below)
1 Domestic 3 Feedlot 6 Oil field water supply 9 Dewatering	2 Irrigation 4 Industrial 7 Lawn and garden only 10 Observation well	

Well's static water level: 15.3 ft. below land surface measured on: 4 month 23 day 79 year	Pump Test Data: None: Well water was ft. after hours pumping.	Est. Yield: Not Pumped gpm: Well water was ft. after hours pumping
--	---	--

4 TYPE OF BLANK CASING USED: 1 Steel 3 RMP (SR) 5 Wrought iron 8 Concrete tile Casing Joints: Glued Clamped	2 PVC 4 ABS 6 Asbestos-Cement 9 Other (specify below) Welded	7 Fiberglass Threaded
---	--	-----------------------

Blank casing dia: 4 in. to 5.0 ft., Dia: in. to ft., Dia: in. to ft.

Casing height above land surface: 29.0 in., weight: 25 lbs./ft. Wall thickness or gauge No: 14 "

TYPE OF SCREEN OR PERFORATION MATERIAL: Steel: 3 Stainless steel 5 Fiberglass 7 PVC 10 Asbestos-cement	2 Brass 4 Galvanized steel 6 Concrete tile 9 ABS 11 Other (specify)	12 None used (open hole)
--	---	--------------------------

Screen or Perforation Openings Are: 1 Continuous slot 3 Mill slot 5 Gauzed wrapped 8 Saw cut 11 None (open hole)	2 Louvered shutter 4 Key punched 6 Wire wrapped 9 Drilled holes	7 Torch cut 10 Other (specify)
--	---	--------------------------------

Screen-Perforation Dia: 16 in. to 10.0 ft., Dia: in. to ft., Dia: in. to ft.

Screen-Perforated Intervals: From: 5.0 ft. to 10.0 ft., From: ft. to ft.

Gravel Pack Intervals: From: 3.0 ft. to 8.0 ft., From: ft. to ft., From: ft. to ft.

5 GROUT MATERIAL: 1 Neat cement 2 Cement grout 3 Bentonite 4 Other	5 Fuel storage 10 Abandoned water well
--	--

Grouted Intervals: From: 0.0 ft. to 3.0 ft., From: 4.0 ft. to 45.0 ft., From: ft. to ft.

What is the nearest source of possible contamination:

1 Septic tank 4 Cess pool 7 Sewage lagoon 11 Fertilizer storage 14 Abandoned water well	2 Sewer lines 5 Seepage pit 8 Feed yard 12 Insecticide storage 15 Oil well/Gas well	3 Lateral lines 6 Pit privy 9 Livestock pens 13 Watertight sewer lines 16 Other (specify below) Pipeline
---	---	--

Direction from well: WSW. How many feet: 10 ? Water Well Disinfected? Yes: No: X

Was a chemical/bacteriological sample submitted to Department? Yes: No: X If yes, date sample

was submitted: month: day: year: Pump Installed? Yes: No: X

If Yes: Pump Manufacturer's name: Model No: HP: Volts: gal/min.

Depth of Pump Intake: ft. Pumps Capacity rated at: gal/min.

Type of pump: 1 Submersible 2 Turbine 3 Jet 4 Centrifugal 5 Reciprocating 6 Other


6 CONTRACTOR'S OR LANDOWNER'S CERTIFICATION: This water well was (1) constructed, (2) reconstructed, or (3) plugged under my jurisdiction and was completed on: 8 month: 22 day: 78 year
--

and this record is true to the best of my knowledge and belief. Kansas Water Well Contractor's License No: 149

This Water Well Record was completed on: 3 month: 3 day: 80 year under the business

name of LAYNE - WESTERN CO., INC. by (signature) *Daryl S. Agg*

7 LOCATE WELL'S LOCATION WITH AN "X" IN SECTION BOX:	FROM 0° 65° 90° 80° 31° 31°	TO 65° 90° 31° 45°	LITHOLOGIC LOG BROWN CLAY BROWN LS. GREY - BROWN SH. GREY LS.	FROM	TO	LITHOLOGIC LOG
--	---	--------------------------------	---	------	----	----------------

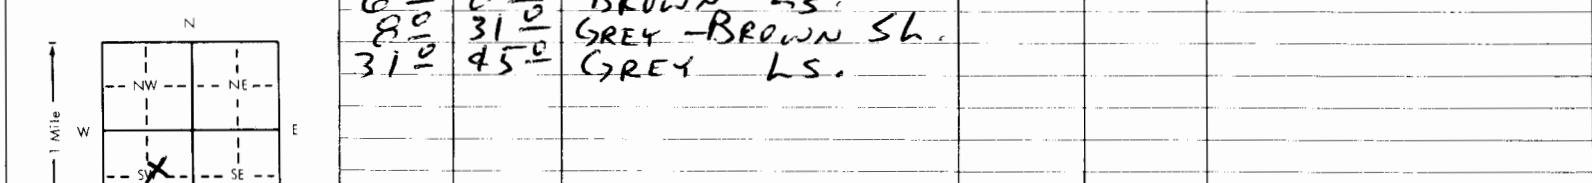

ELEVATION: 1316.8 ft. (Use a second sheet if needed)

Depth(s) Groundwater Encountered: 1 ft. 2 ft. 3 ft. 4 ft. (Use a second sheet if needed)

INSTRUCTIONS: Use typewriter or ball point pen, please press firmly and PRINT clearly. Please fill in blanks, underline or circle the correct answers. Send top three copies to Kansas Department of Health and Environment, Division of Environment, Water Well Contractors, Topeka, KS 66620. Send one to WATER WELL OWNER and retain one for your records.