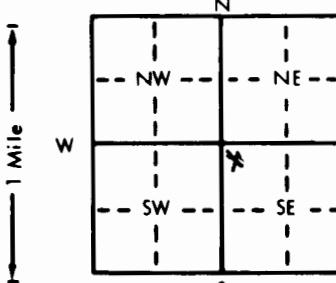


1 LOCATION OF WATER WELL: County: BUTLER	Fraction: WW 1/4 NW 1/4 SE 1/4	Section Number: 10	Township Number: T 26 S	Range Number: R 5 E
Distance and direction from nearest town or city street address of well if located within city? TEXACO REFINERY MW 165				
2 WATER WELL OWNER: RR#, St. Address, Box # : City, State, ZIP Code : PO BOX 1121 ELDORADO KS	Board of Agriculture, Division of Water Resources Application Number:			
3 LOCATE WELL'S LOCATION WITH AN "X" IN SECTION BOX: 	4 DEPTH OF COMPLETED WELL 28 ft. ELEVATION: ft. Depth(s) Groundwater Encountered 1 ft. ft. 2. ft. 3. ft. WELL'S STATIC WATER LEVEL 999 ft. below land surface measured on mo/day/yr Pump test data: Well water was ft. after hours pumping gpm Est. Yield gpm: Well water was ft. after hours pumping gpm Bore Hole Diameter 10 in. to 28 ft. and in. to ft. WELL WATER TO BE USED AS: 5 Public water supply 8 Air conditioning 11 Injection well 1 Domestic 3 Feedlot 6 Oil field water supply 9 Dewatering 12 Other (Specify below) 2 Irrigation 4 Industrial 7 Lawn and garden only 10 Monitoring well Was a chemical/bacteriological sample submitted to Department? Yes No If yes, mo/day/yr sample was submitted Water Well Disinfected? Yes No /			
5 TYPE OF BLANK CASING USED: 1 Steel 3 RMP (SR) 2 PVC 4 ABS	5 Wrought iron 8 Concrete tile 6 Asbestos-Cement 9 Other (specify below) 7 Fiberglass	CASING JOINTS: Glued Clamped Welded Threaded /		
Blank casing diameter 2 in. to 8 ft. Dia in. to ft. Dia in. to ft.	Casing height above land surface 24 in., weight lbs./ft. Wall thickness or gauge No. /			
TYPE OF SCREEN OR PERFORATION MATERIAL: 1 Steel 3 Stainless steel 5 Fiberglass 8 RMP (SR) 10 Asbestos-cement 2 Brass 4 Galvanized steel 6 Concrete tile 9 ABS 11 Other (specify) 12 None used (open hole)				
SCREEN OR PERFORATION OPENINGS ARE: 1 Continuous slot 3 Mill slot 5 Gauzed wrapped 8 Saw cut 11 None (open hole) 2 Louvered shutter 4 Key punched 6 Wire wrapped 9 Drilled holes 7 Torch cut 10 Other (specify) /				
SCREEN-PERFORATED INTERVALS: From 0 ft. to 28 ft. From ft. to ft. From ft. to ft. From ft. to ft. From ft. to ft. From ft. to ft.				
GRAVEL PACK INTERVALS: From 6 ft. to 28 ft. From ft. to ft. From ft. to ft. From ft. to ft.				
6 GROUT MATERIAL: 1 Neat cement Grout Intervals: From 0 ft. to 6 ft., From ft. to ft., From ft. to ft., From ft. to ft.	2 Cement grout 3 Bentonite	4 Other 10 Livestock pens 11 Fuel storage 12 Fertilizer storage 13 Insecticide storage	14 Abandoned water well 15 Oil well/Gas well 16 Other (specify below) REFINERY	
What is the nearest source of possible contamination: 1 Septic tank 4 Lateral lines 7 Pit privy 2 Sewer lines 5 Cess pool 8 Sewage lagoon 3 Watertight sewer lines 6 Seepage pit 9 Feedyard How many feet? WITHIN				
Direction from well? WITHIN	LITHOLOGIC LOG SILTY CITY W/ SHALE + LIME STONE			
PLUGGING INTERVALS				

7 CONTRACTOR'S OR LANDOWNER'S CERTIFICATION: This water well was **(1)** constructed, **(2)** reconstructed, or **(3)** plugged under my jurisdiction and was completed on (mo/day/year) **8/30/93** and this record is true to the best of my knowledge and belief. Kansas Water Well Contractor's License No. **102** This Water Well Record was completed on (mo/day/year) **8/30/93** by (signature) **B. M. M.**
under the business name of **LAYNE**