

1 LOCATION OF WATER WELL:

County: BUTLER

Fraction

NW $\frac{1}{4}$ NW $\frac{1}{4}$ SE $\frac{1}{4}$

Section Number

10

Township Number

T 26 S

Range Number

R 5 EW

Distance and direction from nearest town or city street address of well if located within city?

TEXACO REFINERYMW 164

2 WATER WELL OWNER:

RR#, St. Address, Box # :

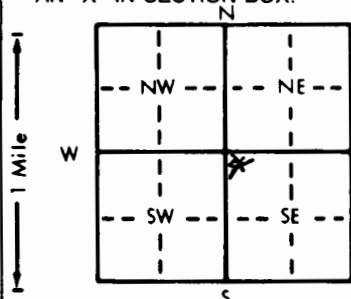
City, State, ZIP Code

TEXACOPO BOX 1121 EL DORADO KS

Board of Agriculture, Division of Water Resources

Application Number:

3 LOCATE WELL'S LOCATION WITH AN "X" IN SECTION BOX:

4 DEPTH OF COMPLETED WELL 22.5 ft. ELEVATION:Depth(s) Groundwater Encountered 1 ft. 2. ft. 3. ft.WELL'S STATIC WATER LEVEL 999 ft. below land surface measured on mo/day/yr

Pump test data: Well water was ft. after hours pumping gpm

Est. Yield gpm: Well water was ft. after hours pumping gpm

Bore Hole Diameter 10 in. to 22.5 ft. and in. to ft.

WELL WATER TO BE USED AS: 5 Public water supply 8 Air conditioning 11 Injection well

1 Domestic 3 Feedlot 6 Oil field water supply 9 Dewatering 12 Other (Specify below)

2 Irrigation 4 Industrial 7 Lawn and garden only 10 Monitoring well

Was a chemical/bacteriological sample submitted to Department? Yes No If yes, mo/day/yr sample was submitted

Water Well Disinfected? Yes No

5 TYPE OF BLANK CASING USED:

1 Steel

3 RMP (SR)

5 Wrought iron

8 Concrete tile

CASING JOINTS: Glued Clamped

2 RVC

4 ABS

6 Asbestos-Cement

9 Other (specify below)

Welded

Blank casing diameter 2 in. to 7.5 ft. Dia

7 Fiberglass

Threaded

Casing height above land surface 24 in. weight lbs./ft. Wall thickness or gauge No.

TYPE OF SCREEN OR PERFORATION MATERIAL:

1 Steel

3 Stainless steel

5 Fiberglass

8 RMP (SR)

10 Asbestos-cement

2 Brass

4 Galvanized steel

6 Concrete tile

9 ABS

12 None used (open hole)

SCREEN OR PERFORATION OPENINGS ARE:

1 Continuous slot

3 Mill slot

5 Gauzed wrapped

8 Saw cut

11 None (open hole)

2 Louvered shutter

4 Key punched

6 Wire wrapped

9 Drilled holes

SCREEN-PERFORATED INTERVALS: From 7.5 ft. to 22.5 ft. From ft. to ft.

From ft. to ft. From ft. to ft.

GRAVEL PACK INTERVALS: From 5.5 ft. to 22.5 ft. From ft. to ft.

From ft. to ft. From ft. to ft.

6 GROUT MATERIAL:

1 Neat cement

2 Cement grout

3 Bentonite

4 Other

Grout Intervals: From 0 ft. to 5.5 ft. From ft. to ft. From ft. to ft.

What is the nearest source of possible contamination:

1 Septic tank

4 Lateral lines

7 Pit privy

10 Livestock pens

14 Abandoned water well

2 Sewer lines

5 Cess pool

8 Sewage lagoon

11 Fuel storage

15 Oil well/Gas well

3 Watertight sewer lines

6 Seepage pit

9 Feedyard

12 Fertilizer storage

16 Other (specify below)

13 Insecticide storage

REFINERY

Direction from well?

WITHIN

How many feet?

WITHIN

FROM

TO

LITHOLOGIC LOG

FROM

TO

PLUGGING INTERVALS

0 TO SILTY CLAY & SHALEW/ LIMESTONE

7 CONTRACTOR'S OR LANDOWNER'S CERTIFICATION: This water well was (1) constructed, (2) reconstructed, or (3) plugged under my jurisdiction and was

completed on (mo/day/year) 8/30/93 and this record is true to the best of my knowledge and belief. KansasWater Well Contractor's License No. 102This Water Well Record was completed on (mo/day/yr) 8/30/93under the business name of LAUNE INCby (signature) [Signature]