

## 1 LOCATION OF WATER WELL:

County: BUTLER

Fraction

NW  $\frac{1}{4}$  NW  $\frac{1}{4}$  SE  $\frac{1}{4}$ 

Section Number

10

Township Number

T 26 S

Range Number

R 5 EW

Distance and direction from nearest town or city street address of well if located within city?

TEXACO REFINERYMW 166

## 2 WATER WELL OWNER:

RR#, St. Address, Box # :

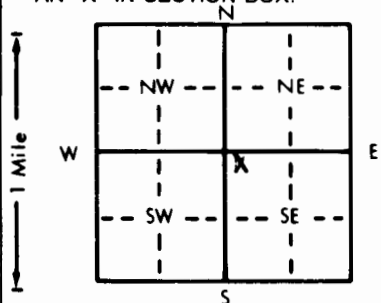
City, State, ZIP Code

TEXACOPO BOX 121

Board of Agriculture, Division of Water Resources

Application Number:

## 3 LOCATE WELL'S LOCATION WITH AN "X" IN SECTION BOX:

4 DEPTH OF COMPLETED WELL: 13 ft. ELEVATION:Depth(s) Groundwater Encountered 1 ft. 2. ft. 3. ft.WELL'S STATIC WATER LEVEL 999 ft. below land surface measured on mo/day/yr

Pump test data: Well water was ft. after hours pumping gpm

Est. Yield gpm: Well water was ft. after hours pumping gpm

Bore Hole Diameter 10 in. to 13 ft., and in. to ft.

WELL WATER TO BE USED AS: 5 Public water supply 8 Air conditioning 11 Injection well

1 Domestic 3 Feedlot 6 Oil field water supply 9 Dewatering 12 Other (Specify below)2 Irrigation 4 Industrial 7 Lawn and garden only 10 Monitoring well

Was a chemical/bacteriological sample submitted to Department? Yes No If yes, mo/day/yr sample was submitted

Water Well Disinfected? Yes No

## 5 TYPE OF BLANK CASING USED:

1 Steel 3 RMP (SR)

2 PVC 4 ABS

5 Wrought iron

6 Asbestos-Cement

7 Fiberglass

8 Concrete tile

9 Other (specify below)

CASING JOINTS: Glued Clamped

Welded

Threaded

Blank casing diameter in. to ft. Dia. in. to ft. Dia. in. to ft.

Casing height above land surface in. weight lbs./ft. Wall thickness or gauge No.

## TYPE OF SCREEN OR PERFORATION MATERIAL:

1 Steel 3 Stainless steel

2 Brass 4 Galvanized steel

5 Fiberglass

6 Concrete tile

7 PVC

8 RMP (SR)

9 ABS

10 Asbestos-cement

11 Other (specify)

12 None used (open hole)

## SCREEN OR PERFORATION OPENINGS ARE:

1 Continuous slot

3 Mill slot

2 Louvered shutter

4 Key punched

5 Gauzed wrapped

6 Wire wrapped

7 Torch cut

8 Saw cut

9 Drilled holes

10 Other (specify)

11 None (open hole)

SCREEN-PERFORATED INTERVALS: From ft. to ft. From ft. to ft. From ft. to ft.

From ft. to ft. From ft. to ft. From ft. to ft.

GRAVEL PACK INTERVALS: From ft. to ft. From ft. to ft. From ft. to ft.

From ft. to ft. From ft. to ft. From ft. to ft.

## 6 GROUT MATERIAL:

1 Neat cement

2 Cement grout

3 Bentonite

4 Other

Grout Intervals: From ft. to ft. From ft. to ft. From ft. to ft. From ft. to ft.

What is the nearest source of possible contamination:

1 Septic tank

4 Lateral lines

7 Pit privy

10 Livestock pens

14 Abandoned water well

2 Sewer lines

5 Cess pool

8 Sewage lagoon

11 Fuel storage

15 Oil well/Gas well

3 Watertight sewer lines

6 Seepage pit

9 Feedyard

12 Fertilizer storage

13 Insecticide storage

16 Other (specify below)

REFINERY

Direction from well?

WITHIN

How many feet?

WITHIN

FROM TO LITHOLOGIC LOG

FROM TO

PLUGGING INTERVALS

TO SILTY CLAYW/ SHALE + LIMESTONE7 CONTRACTOR'S OR LANDOWNER'S CERTIFICATION: This water well was (1) constructed, (2) reconstructed, or (3) plugged under my jurisdiction and was completed on (mo/day/year) 8/30/93 and this record is true to the best of my knowledge and belief. KansasWater Well Contractor's License No. 102 This Water Well Record was completed on (mo/day/yr) 8/30/93under the business name of LAYNE INC

by (signature)

Ames