

1 LOCATION OF WATER WELL:	Fraction SE 1/4 SE 1/4 SE 1/4	Section Number 10	Township Number T 26 S	Range Number R 5
---------------------------	----------------------------------	----------------------	---------------------------	---------------------

Distance and direction from nearest town or city street address of well if located within city?

1/2 mile South of Eldorado, Kansas

2 WATER WELL OWNER: Getty Refining & Marketing


RR#, St. Address, Box #: 1401 South Douglas Road

Board of Agriculture, Division of Water Resources

City, State, ZIP Code: Eldorado, Kansas 67042

Application Number:

3 LOCATE WELL'S LOCATION WITH AN "X" IN SECTION BOX:

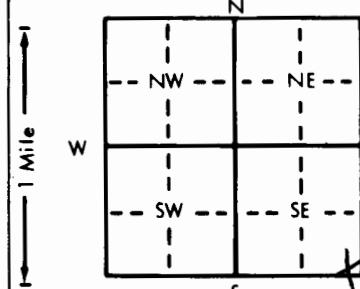

4 DEPTH OF COMPLETED WELL .18.88 ft. ELEVATION: 1251.12

Depth(s) Groundwater Encountered 1. ft. 2. ft. 3. ft.

WELL'S STATIC WATER LEVEL .8.12 ft. below land surface measured on mo/day/yr 3/11/81

Pump test data: Well water was ft. after hours pumping gpm

Est. Yield .15. gpm: Well water was ft. after hours pumping gpm

Bore Hole Diameter .48. in. to Total Depth, and in. to ft.

WELL WATER TO BE USED AS: 5 Public water supply 8 Air conditioning 11 Injection well

1 Domestic 3 Feedlot 6 Oil field water supply 9 Dewatering 12 Other (Specify below)

2 Irrigation 4 Industrial 7 Lawn and garden only 10 Observation well Recovery Well

Was a chemical/bacteriological sample submitted to Department? Yes.....No. X..... If yes, mo/day/yr sample was submittedWater Well Disinfected? Yes No X

5 TYPE OF BLANK CASING USED:

1 Steel 3 RMP (SR) 5 Wrought iron 8 Concrete tile CASING JOINTS: Glued Clamped
2 PVC 4 ABS 6 Asbestos-Cement 9 Other (specify below) Welded Yes
7 Corr. Metal Pipe Threaded

Blank casing diameter .36. in. to ft., Dia. in. to in. to ft., Dia. in. to in. to ft.

Casing height above land surface .45.5 in., weight .36. lbs./ft. Wall thickness or gauge No. 14.

TYPE OF SCREEN OR PERFORATION MATERIAL:

1 Steel 3 Stainless steel 5 Fiberglass 8 RMP (SR) 10 Asbestos-cement
2 Brass 4 Galvanized steel 6 Concrete tile 9 ABS 11 Other (specify)
12 None used (open hole)

SCREEN OR PERFORATION OPENINGS ARE:

1 Continuous slot 3 Mill slot 5 Gauzed wrapped 8 Saw cut 11 None (open hole)
2 Louvered shutter 4 Key punched 6 Wire wrapped 9 Drilled holes
7 Torch cut 10 Other (specify)

SCREEN-PERFORATED INTERVALS: From .10.71 ft. to .18.88 ft., From ft. to ft. to ft.

From ft. to ft., From ft. to ft. to ft.

GRAVEL PACK INTERVALS: From .9.0 ft. to .18.88 ft., From ft. to ft. to ft.
From ft. to ft., From ft. to ft. to ft.

6 GROUT MATERIAL: 1 Neat cement 2 Cement grout 3 Bentonite 4 Other

Grout Intervals: From .0.0 ft. to .9.0 ft., From ft. to ft., From ft. to ft. to ft.

What is the nearest source of possible contamination:

1 Septic tank 4 Lateral lines 7 Pit privy 10 Livestock pens 14 Abandoned water well
2 Sewer lines 5 Cess pool 8 Sewage lagoon 11 Fuel storage 15 Oil well/Gas well
3 Watertight sewer lines 6 Seepage pit 9 Feedyard 12 Fertilizer storage 16 Other (specify below)
13 Insecticide storage

Direction from well? West How many feet? 12'

FROM TO LITHOLOGIC LOG FROM TO LITHOLOGIC LOG

0.0 10.0 Fill

10.0 16.0 Silty clay

16.0 18.9 Gravel & Boulders

18.9 Bedrock

7 CONTRACTOR'S OR LANDOWNER'S CERTIFICATION: This water well was (1) constructed, (2) reconstructed, or (3) plugged under my jurisdiction and was completed on (mo/day/year) 3/11/81 and this record is true to the best of my knowledge and belief. Kansas

Water Well Contractor's License No. 102 This Water Well Record was completed on (mo/day/yr) 6/9/81

under the business name of Layne-Western Co., Inc. by (signature) Diana S. Bennington

INSTRUCTIONS: Use typewriter or ball point pen, PLEASE PRESS FIRMLY and PRINT clearly. Please fill in blanks, underline or circle the correct answers. Send top three copies to Kansas Department of Health and Environment, Division of Environment, Environmental Geology Section, Topeka, KS 66620. Send one to WATER WELL OWNER and retain one for your records.