WATER WELL RECORD Form WWC-5 KSA 82a-1212 OE-4

1 LOCATION OF WATER WELL:

County:	Fraction	Section Number	Township Number	Range Number
Butler	SE ¼ SE ¼ SE ¼	10	T 26 S	R 5 (E)/W

Distance and direction from nearest town or city street address of well if located within city?
1/2 Mile South of El Dorado, Kansas

2 WATER WELL OWNER: Getty Refining & Marketing Co.
RR#, St. Address, Box # : 1401 South Douglas Road
City, State, ZIP Code : El Dorado, Kansas 67042

Board of Agriculture, Division of Water Resources
Application Number:

3 LOCATE WELL'S LOCATION WITH AN "X" IN SECTION BOX:

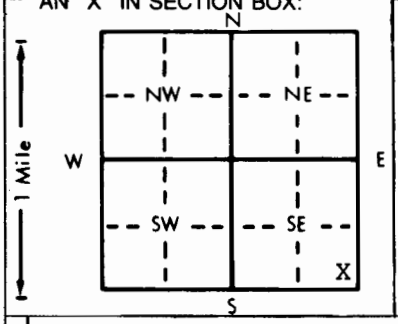

4 DEPTH OF COMPLETED WELL 15.2 ft. ELEVATION: 1254.8
Depth(s) Groundwater Encountered 1. ..... ft. 2. ..... ft. 3. ..... ft.
WELL'S STATIC WATER LEVEL 1.9 ft. below land surface measured on mo/day/yr 3/18/81
Pump test data: Well water was ..... ft. after ..... hours pumping ..... gpm
Est. Yield ..... gpm: Well water was ..... ft. after ..... hours pumping ..... gpm
Bore Hole Diameter 6 in. to Total depth ft., and ..... in. to ..... ft.
WELL WATER TO BE USED AS: 5 Public water supply 8 Air conditioning 11 Injection well
1 Domestic 3 Feedlot 6 Oil field water supply 9 Dewatering 12 Other (Specify below)
2 Irrigation 4 Industrial 7 Lawn and garden only (10) Observation well
Was a chemical/bacteriological sample submitted to Department? Yes ..... No X ; If yes, mo/day/yr sample was submitted
Water Well Disinfected? Yes No X

5 TYPE OF BLANK CASING USED: 5 Wrought iron 8 Concrete tile CASING JOINTS: Glued ..... Clamped .....
(1) Steel 3 RMP (SR) 6 Asbestos-Cement 9 Other (specify below) Welded Yes
2 PVC 4 ABS 7 Fiberglass Threaded .....
Blank casing diameter 4 in. to ..... ft., Dia ..... in. to ..... ft., Dia ..... in. to ..... ft.
Casing height above land surface 39.6 in., weight 10.8 lbs./ft. Wall thickness or gauge No. 14
TYPE OF SCREEN OR PERFORATION MATERIAL: 7 PVC 10 Asbestos-cement
1 Steel 3 Stainless steel 5 Fiberglass 8 RMP (SR) 11 Other (specify) .....
2 Brass (4) Galvanized steel 6 Concrete tile 9 ABS 12 None used (open hole)
SCREEN OR PERFORATION OPENINGS ARE: 5 Gauzed wrapped 8 Saw cut 11 None (open hole)
(1) Continuous slot 3 Mill slot 6 Wire wrapped 9 Drilled holes
2 Louvered shutter 4 Key punched 7 Torch cut 10 Other (specify) .....
SCREEN-PERFORATED INTERVALS: From 7.2 ft. to 15.2 ft., From ..... ft. to ..... ft.
From ..... ft. to ..... ft., From ..... ft. to ..... ft.
GRAVEL PACK INTERVALS: From 6.2 ft. to 15.2 ft., From ..... ft. to ..... ft.
From ..... ft. to ..... ft., From ..... ft. to ..... ft.

6 GROUT MATERIAL: (1) Neat cement 2 Cement grout 3 Bentonite 4 Other .....
Grout Intervals: From 0.0 ft. to 6.2 ft., From ..... ft. to ..... ft., From ..... ft. to ..... ft.
What is the nearest source of possible contamination: 10 Livestock pens 14 Abandoned water well
1 Septic tank 4 Lateral lines 7 Pit privy (11) Fuel storage 15 Oil well/Gas well
2 Sewer lines 5 Cess pool 8 Sewage lagoon 12 Fertilizer storage 16 Other (specify below)
3 Watertight sewer lines 6 Seepage pit 9 Feedyard 13 Insecticide storage .....
Direction from well? Southwest How many feet? 20'

FROM	TO	LITHOLOGIC LOG	FROM	TO	LITHOLOGIC LOG
0.0	3.0	Dark brown silty clay, moist, stiff			
3.0	10.0	Red brown silty clay, moist, very stiff			
10.0	15.2	Dark brown clay, very moist			
15.2		Bedrock			

7 CONTRACTOR'S OR LANDOWNER'S CERTIFICATION: This water well was (1) constructed, (2) reconstructed, or (3) plugged under my jurisdiction and was completed on (mo/day/year) 3/18/81 and this record is true to the best of my knowledge and belief. Kansas Water Well Contractor's License No. 102 This Water Well Record was completed on (mo/day/yr) 6/9/81
under the business name of LAYNE-WESTERN CO. INC. by (signature) Diana L. Bennington

INSTRUCTIONS: Use typewriter or ball point pen, *PLEASE PRESS FIRMLY* and *PRINT* clearly. Please fill in blanks, underline or circle the correct answers. Send top three copies to Kansas Department of Health and Environment, Division of Environment, Environmental Geology Section, Topeka, KS 66620. Send one to WATER WELL OWNER and retain one for your records.