

1 LOCATION OF WATER WELL:	Fraction	Section Number	Township Number	Range Number
---------------------------	----------	----------------	-----------------	--------------

County: Butler	SW 1/4 SW 1/4 SW 1/4	12	T 26 S	R 5 E
-----------------------	-----------------------------	-----------	---------------	--------------

Distance and direction from nearest town or city street address of well if located within city
EAST EDGE **150 FT** **E. L. Dorado**


2 WATER WELL OWNER: **SATRA DRILLING**

RR#, St. Address, Box # :

City, State, ZIP Code : **ELDORAD KS 67042**

Board of Agriculture, Division of Water Resource
 Application Number:

3 LOCATE WELL'S LOCATION WITH
 AN "X" IN SECTION BOX:

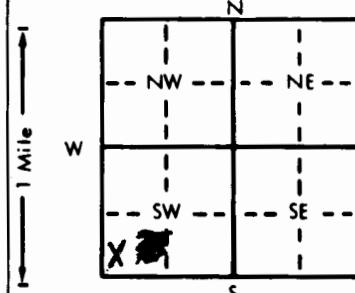

4 DEPTH OF COMPLETED WELL **40** ft. ELEVATION:

Depth(s) Groundwater Encountered **1.25** ft. 2. ft. 3. ft.

WELL'S STATIC WATER LEVEL **17'** ft. below land surface measured on mo/day/yr

Pump test data: Well water was **17'** ft. after **2** hours pumping **10** gpm

Est. Yield **10** gpm: Well water was ft. after hours pumping gpm

Bore Hole Diameter **10** in. to **40** ft. and in. to ft.

WELL WATER TO BE USED AS: 5 Public water supply 8 Air conditioning 11 Injection well

1 Domestic 3 Feedlot 6 Oil field water supply 9 Dewatering 12 Other (Specify below)

2 Irrigation 4 Industrial 7 Lawn and garden only 10 Observation well

Was a chemical/bacteriological sample submitted to Department? Yes **NO**; If yes, mo/day/yr sample was submitted

Water Well Disinfected? Yes **YES** No

5 TYPE OF BLANK CASING USED:

1 Steel 3 RMP (SR)
 2 PVC 4 ABS

5 Wrought iron

6 Asbestos-Cement

7 Fiberglass

8 Concrete tile

9 Other (specify below)

CASING JOINTS: Glued

Clamped

Welded

Threaded

Blank casing diameter **3'** in. to **40** ft. Dia in. to ft. Dia in. to ft.

Casing height above land surface **3'** in., weight lbs./ft. Wall thickness or gauge No.

TYPE OF SCREEN OR PERFORATION MATERIAL:

1 Steel 3 Stainless steel 5 Fiberglass 8 RMP (SR)
 2 Brass 4 Galvanized steel 6 Concrete tile 9 ABS

1 Continuous slot 3 Mill slot 5 Gauzed wrapped 8 Saw cut 10 Asbestos-cement
 2 Louvered shutter 4 Key punched 6 Wire wrapped 9 Drilled holes 11 Other (specify)
 7 Torch cut 10 Other (specify) 12 None used (open hole)

7 PVC

SCREEN OR PERFORATION OPENINGS ARE:

1 Continuous slot 3 Mill slot
 2 Louvered shutter 4 Key punched

5 Gauzed wrapped

6 Wire wrapped

7 Torch cut

8 Saw cut

9 Drilled holes

10 Other (specify)

11 None (open hole)

SCREEN-PERFORATED INTERVALS: From **17'** ft. to **40'** ft. From ft. to ft. From ft. to ft.

From ft. to ft. From ft. to ft. From ft. to ft.

GRAVEL PACK INTERVALS: From **15'** ft. to **40'** ft. From ft. to ft. From ft. to ft.

From ft. to ft. From ft. to ft. From ft. to ft.

6 GROUT MATERIAL: 1 Neat cement 2 Cement grout 3 Bentonite 4 Other

Grout Intervals: From **15'** ft. to **3'** ft. From ft. to ft. From ft. to ft.

What is the nearest source of possible contamination:

1 Septic tank 4 Lateral lines
 2 Sewer lines 5 Cess pool
 3 Watertight sewer lines 6 Seepage pit

7 Pit privy 10 Livestock pens 14 Abandoned water well

8 Sewage lagoon 11 Fuel storage 15 Oil well/Gas well

9 Feedyard 12 Fertilizer storage 16 Other (specify below)

13 Insecticide storage

How many feet?

150

Direction from well? **W**

FROM TO LITHOLOGIC LOG FROM TO LITHOLOGIC LOG

0 25 150 ft

25 28 11 ft gravel

28 40 4 ft clay

7 CONTRACTOR'S OR LANDOWNER'S CERTIFICATION: This water well was (1) constructed, (2) reconstructed, or (3) plugged under my jurisdiction and was completed on (mo/day/year) **9-24-86** and this record is true to the best of my knowledge and belief. Kansas

Water Well Contractor's License No. **414** This Water Well Record was completed on (mo/day/yr) **9-29-86**

under the business name of **H & S DRILLING** by (signature) **Digital Signature**

INSTRUCTIONS: Use typewriter or ball point pen. PLEASE PRESS FIRMLY and PRINT clearly. Please fill in blanks, underline or circle the correct answers. Send up three copies to Kansas Department of Health and Environment, Office of Oil Field and Environmental Geology, Regulation and Permitting Section, Topeka, Kansas 66620-7500, Telephone: 913-862-9360. Send one to WATER WELL OWNER and retain one for your records.