
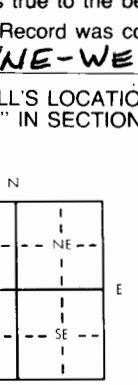


1 LOCATION OF WATER WELL 19		Fraction SW 1/4 SW 1/4 NW 1/4		Section Number 15	Township Number T 26 S	Range Number R 50 EW	
County: BUTLER		Distance and direction from nearest town or city? SW Corner of Town		Street address of well if located within city?		1401 S. Douglas Rd. El Dorado, Kansas	
2 WATER WELL OWNER: Getty Refining & Marketing Co.		RR#, St. Address, Box #: P. O. Box 1121		Board of Agriculture, Division of Water Resources Application Number:			
City, State, ZIP Code: El Dorado, Kansas 67042							
3 DEPTH OF COMPLETED WELL: 67.8 ft.		Bore Hole Diameter: 6 in. to 14 ft., and 4 in. to 67.8 ft.					
Well Water to be used as: 1 Domestic 2 Irrigation		5 Public water supply	8 Air conditioning	11 Injection well			
3 Feedlot		6 Oil field water supply	9 Dewatering	12 Other (Specify below)			
4 Industrial		7 Lawn and garden only	10 Observation well				
Well's static water level: 11.6 ft.		below land surface measured on	10 month	23 day	79 year		
Pump Test Data: None		Well water was ft. after	hours pumping	gpm			
Est. Yield Not Pumped gpm:		Well water was ft. after	hours pumping	gpm			
4 TYPE OF BLANK CASING USED: 1 Steel 2 PVC		5 Wrought iron	8 Concrete tile	Casing Joints: Glued Clamped			
3 RMP (SR) 4 ABS		6 Asbestos-Cement	9 Other (specify below)	Welded			
Blank casing dia: 4 in. to 7.0 ft.		7 Fiberglass		Threaded			
Casing height above land surface: 19 in., weight		10 ft. Dia	11 lbs./ft. Wall thickness or gauge No. 14				
TYPE OF SCREEN OR PERFORATION MATERIAL: 1 Steel 2 Brass		5 Fiberglass	7 PVC	10 Asbestos-cement			
3 Stainless steel 4 Galvanized steel		6 Concrete tile	8 RMP (SR)	11 Other (specify)			
Screen or Perforation Openings Are: 1 Continuous slot 2 Louvered shutter		5 Gauzed wrapped	9 ABS	12 None used (open hole)			
3 Mill slot 4 Key punched		6 Wire wrapped	10 Other (specify)				
Screen-Perforation Dia: 16 in. to 15.6 ft.		7 Torch cut	11 Saw cut	11 None (open hole)			
5 GROUT MATERIAL: 1 Neat cement		2 Cement grout	3 Bentonite	4 Other			
Grouted Intervals: From: 0.0 ft. to 3.0 ft.		10 Fuel storage	11 Fertilizer storage	14 Abandoned water well			
What is the nearest source of possible contamination: 1 Septic tank 2 Sewer lines 3 Lateral lines		7 Sewage lagoon	8 Feed yard	15 Oil well/Gas well			
4 Cess pool 5 Seepage pit 6 Pit privy		9 Livestock pens	10 Insecticide storage	16 Other (specify below) EVAP. PONDS			
Direction from well: SE		11 Watertight sewer lines	12 Pump Installed? Yes No X	13 Pump Installed? Yes No X			
How many feet: 750		13 Water Well Disinfected? Yes No X				14 Abandoned water well	
Was a chemical/bacteriological sample submitted to Department? Yes No X					If yes, date sample		
Was submitted month day year: Pump Installed? Yes No X							
If Yes: Pump Manufacturer's name:		Model No.	HP	Volts			
Depth of Pump Intake: ft.		Pumps Capacity rated at: gal./min.					
Type of pump: 1 Submersible 2 Turbine 3 Jet		4 Centrifugal	5 Reciprocating	6 Other			
6 CONTRACTOR'S OR LANDOWNER'S CERTIFICATION: This water well was (1) constructed, (2) reconstructed, or (3) plugged under my jurisdiction and was completed on: 9 month 12 day 78 year							
and this record is true to the best of my knowledge and belief. Kansas Water Well Contractor's License No. 149							
This Water Well Record was completed on: 3 month 2 day 80 by (signature) David B. Higgins							
7 LOCATE WELL'S LOCATION WITH AN "X" IN SECTION BOX:		FROM 0° 11° 11° 14° 14° 29° 29°	TO 11° 14° 29° 67°	LITHOLOGIC LOG BROWN CLAY GRAVEL BROWN LS. GREY LS.	FROM	TO	LITHOLOGIC LOG
							
ELEVATION: 1283.1							
Depth(s) Groundwater Encountered: 1 ft. 2 ft. 3 ft. 4 ft.					(Use a second sheet if needed)		

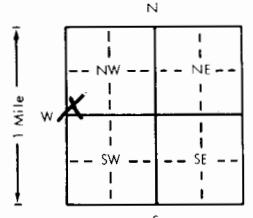

1 Mile
ELEVATION: 1283

Depth(s) Groundwater Encountered 1 ft 2 ft 3 ft 4 ft (Use a second sheet if needed)

INSTRUCTIONS: Use typewriter or ball point pen, **please press firmly** and **PRINT** clearly. Please fill in blanks, underline or circle the correct answers. Send top three copies to Kansas Department of Health and Environment, Division of Environment, Water Well Contractors, Topeka, KS 66620. Send one to **WATER WELL OWNER** and retain one for your records.