


1 LOCATION OF WATER WELL:		Fraction		Section Number		Township Number		Range Number	
County:	Butler	NE ¼	NE ¼	NE ¼	15	T 26	S	R 5	EA

Distance and direction from nearest town or city street address of well if located within city?

1/2 mi South of Eldorado, Kansas

2	WATER WELL OWNER:	Getty Refining & Marketing Company	
	RR#, St. Address, Box # :	1401 South Douglas Road	Board of Agriculture, Division of Water Resources
	City, State, ZIP Code :	Eldorado, Kansas 67042	Application Number:

3	LOCATE WELL'S LOCATION WITH AN "X" IN SECTION BOX:	4	DEPTH OF COMPLETED WELL	15.08	ft.	ELEVATION:	1254.92
---	--	---	-------------------------	-------	-----	------------	---------

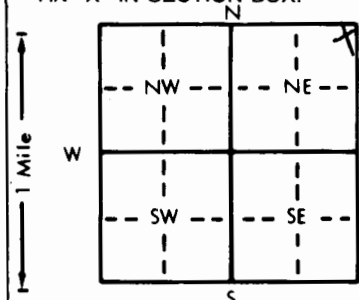

Depth(s) Groundwater Encountered 1. ft. 2. ft. 3. ft.

WELL'S STATIC WATER LEVEL ... 6.53 ... ft. below land surface measured on mo/day/yr ... 3/11/81

Pump test data: Well water was ft. after hours pumping gpm

Est. Yield .. 25 ... gpm: Well water was ft. after hours pumping gpm

Bore Hole Diameter 48 in. to Total Depth ft. and in. to ft.

WELL WATER TO BE USED AS: 5 Public water supply 8 Air conditioning 11 Injection well

1 Domestic 3 Feedlot 6 Oil field water supply 9 Dewatering 12 Other (Specify below)

2 Irrigation 4 Industrial 7 Lawn and garden only 10 Observation well Recovery Well

Was a chemical/bacteriological sample submitted to Department? Yes.....No X.....; If yes, mo/day/yr sample was sub-

mitted Water Well Disinfected? Yes No **X**

5	TYPE OF BLANK CASING USED:		5 Wrought iron	8 Concrete tile	CASING JOINTS: Glued Clamped
	1 Steel	3 RMP (SR)	6 Asbestos-Cement	9 Other (specify below)	Welded . Yes
	2 PVC	4 ABS	7 Fiberglass	Corr. Metal Pipe	Threaded

Blank casing diameter . . . 36 . . . in. to . . . ft. Dia . . . in. to . . . ft. Dia . . . in. to . . . ft.

Casing height above land surface. 48 in. weight 36 lbs./ft. Wall thickness or gauge No. 14

TYPE OF SCREEN OR PERFORATION MATERIAL:	7 PVC	10 Asbestos-cement
---	-------	--------------------

1 Steel 3 Stainless steel 5 Fiberglass 8 RMP (SR) 11 Other (specify)

2 Brass 4 Galvanized steel 6 Concrete tile 9 ABS 12 None used (open hole)

SCREEN OR PERFORATION OPENINGS ARE: 5 Gauzed wrapped 8 Saw cut 11 None (open hole)

(1) Continuous slot 3 Mill slot 6 Wire wrapped 9 Drilled holes

2 Louvered shutter 4 Key punched 7 Torch cut 10 Other (specify)

SCREEN-PERFORATED INTERVALS: From 8.91 ft. to 15.08 ft. From . ft. to . ft.

From ft. to ft., From ft. to ft.

GRAVEL PACK INTERVALS: From 6.6 ft. to 15.08 ft., From . ft. to . ft.

From	ft. to	ft., From	ft. to	ft.

6	GROUT MATERIAL:				1 Neat cement	2 Cement grout	3 Bentonite	4 Other
Grout Intervals:		From	0.0	ft. to	6.6	ft.	From	ft. to

What is the nearest source of possible contamination: 10 Livestock pens 14 Abandoned water well

1 Septic tank 4 Lateral lines 7 Pit privy 11 Fuel storage 15 Oil well/Gas well

2 Sewer lines	5 Cess pool	8 Sewage lagoon	12 Fertilizer storage	16 Other (specify below)
---------------	-------------	-----------------	-----------------------	--------------------------

3 Watertight sewer lines 6 Seepage pit 9 Feedyard 13 Insecticide storage

Direction from well? NW How many feet? 20'

[illegible]

7 CONTRACTOR'S OR LANDOWNER'S CERTIFICATION: This water well was (1) constructed, (2) reconstructed, or (3) plugged under my jurisdiction and was completed on (mo/day/year) . . . 3/11/81 and this record is true to the best of my knowledge and belief. Kansas Water Well Contractor's License No. . . 102 This Water Well Record was completed on (mo/day/yr) . . . 6/9/81 under the business name of Layne-Western Co., Inc. by (signature) *Diana S. Bennington*

INSTRUCTIONS: Use typewriter or ball point pen, PLEASE PRESS FIRMLY and PRINT clearly. Please fill in blanks, underline or circle the correct answers. Send top three copies to Kansas Department of Health and Environment, Division of Environment, Environmental Geology Section, Topeka, KS 66620. Send one to WATER WELL OWNER and retain one for your records.