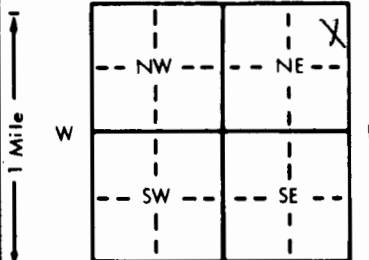


1 LOCATION OF WATER WELL:		Fraction		Section Number		Township Number		Range Number	
County: Butler		NE 1/4 NE 1/4 NE 1/4		15		T 26 S		R 5 EW	
Distance and direction from nearest town or city street address of well if located within city? 1/2 mi. S of Eldorado, Kansas									
2 WATER WELL OWNER: Getty Refining & Marketing									
RR#, St. Address, Box #: 1401 South Douglas Road					Board of Agriculture, Division of Water Resources				
City, State, ZIP Code: Eldorado, Kansas 67042					Application Number:				
3 LOCATE WELL'S LOCATION WITH AN "X" IN SECTION BOX:			4 DEPTH OF COMPLETED WELL: 27.0 ft. ELEVATION: 1243.0'						
			Depth(s) Groundwater Encountered 1. ft. 2. ft. 3. ft.						
			WELL'S STATIC WATER LEVEL: 8.2 ft. below land surface measured on mo/day/yr: 3/9/81						
			Pump test data: Well water was ft. after hours pumping gpm						
			Est. Yield: 10 gpm: Well water was ft. after hours pumping gpm						
			Bore Hole Diameter: .48 in. to Total Depth ft., and in. to ft.						
WELL WATER TO BE USED AS:			5 Public water supply 8 Air conditioning 11 Injection well						
1 Domestic 3 Feedlot 6 Oil field water supply 9 Dewatering 12 Other (Specify below)			Recovery Well						
2 Irrigation 4 Industrial 7 Lawn and garden only 10 Observation well									
Was a chemical/bacteriological sample submitted to Department? Yes. No. X ; If yes, mo/day/yr sample was submitted									
Water Well Disinfected? Yes No X									
5 TYPE OF BLANK CASING USED:									
1 Steel 3 RMP (SR) 5 Wrought iron 8 Concrete tile CASING JOINTS: Glued Clamped									
2 PVC 4 ABS 6 Asbestos-Cement 9 Other (specify below) Welded Yes									
Blank casing diameter: .36 in. to in. Dia. in. to ft., Dia. in. to ft.									
Casing height above land surface: .56 in., weight: .36 lbs./ft. Wall thickness or gauge No. 14									
TYPE OF SCREEN OR PERFORATION MATERIAL:									
1 Steel 3 Stainless steel 5 Fiberglass 8 RMP (SR) 11 Other (specify)									
2 Brass 4 Galvanized steel 6 Concrete tile 9 ABS 12 None used (open hole)									
SCREEN OR PERFORATION OPENINGS ARE:									
1 Continuous slot 3 Mill slot 5 Gauzed wrapped 8 Saw cut 11 None (open hole)									
2 Louvered shutter 4 Key punched 6 Wire wrapped 9 Drilled holes									
7 Torch cut 10 Other (specify)									
SCREEN-PERFORATED INTERVALS: From: 13.63 ft. to 27.0 ft., From ft. to ft.									
GRAVEL PACK INTERVALS: From: 10.0 ft. to 27.0 ft., From ft. to ft.									
6 GROUT MATERIAL: 1 Neat cement 2 Cement grout 3 Bentonite 4 Other									
Grout Intervals: From: 0.0 ft. to 10.0 ft., From ft. to ft., From ft. to ft.									
What is the nearest source of possible contamination:									
1 Septic tank 4 Lateral lines 7 Pit privy 10 Livestock pens 14 Abandoned water well									
2 Sewer lines 5 Cess pool 8 Sewage lagoon 11 Fuel storage 15 Oil well/Gas well									
3 Watertight sewer lines 6 Seepage pit 9 Feedyard 12 Fertilizer storage 16 Other (specify below)									
13 Insecticide storage									
Direction from well? NW How many feet? 40 feet									
FROM TO LITHOLOGIC LOG FROM TO LITHOLOGIC LOG									
0.0 3.0 Topsoil									
3.0 23.5 Silty clay									
23.5 27.0 Gravel & Boulders									
27.0 Bedrock									
7 CONTRACTOR'S OR LANDOWNER'S CERTIFICATION: This water well was (1) constructed, (2) reconstructed, or (3) plugged under my jurisdiction and was completed on (mo/day/year) 3/9/81 and this record is true to the best of my knowledge and belief. Kansas									
Water Well Contractor's License No. 102 This Water Well Record was completed on (mo/day/yr) 6/9/81									
under the business name of LAYNE-WESTERN CO. INC by (signature) <i>Diana Y. Bennington</i>									
INSTRUCTIONS: Use typewriter or ball point pen, PLEASE PRESS FIRMLY and PRINT clearly. Please fill in blanks, underline or circle the correct answers. Send top three copies to Kansas Department of Health and Environment, Division of Environment, Environmental Geology Section, Topeka, KS 66620. Send one to WATER WELL OWNER and retain one for your records.									