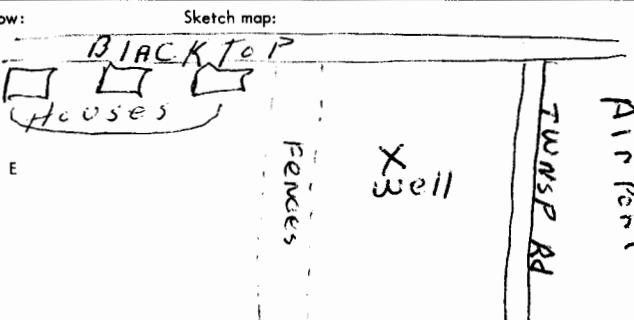


1. Location of well:	County	Fraction	Section number	Township number	Range number
Butler	NE 1/4 NW 1/4 NE 1/4	25	T 26	S R 5	(E/W)
2. Distance and direction from nearest town or city: 2 miles SW of Emporia 76, on 54 Hwy The NEAST 2 1/2 mil Street address of well location if in city: SOUTH SIDE	3. Owner of well: RAE HOBSON R.R. or street: 1211 WEST OLIVE City, state, zip code: 81 DURAD 76 67042				
4. Locate with "X" in section below:	Sketch map: 	5. Type and color of material	From	To	6. Bore hole dia. 10 in. Completion date 10-12-77 Well depth 144 ft.
TOPSOIL	0 2	7. <input checked="" type="checkbox"/> Cable tool <input type="checkbox"/> Rotary <input type="checkbox"/> Driven <input type="checkbox"/> Dug <input type="checkbox"/> Hollow rod <input type="checkbox"/> Jetted <input type="checkbox"/> Bored <input type="checkbox"/> Reverse rotary			
Red CLAY	2 5	8. Use: <input checked="" type="checkbox"/> Domestic <input type="checkbox"/> Public supply <input type="checkbox"/> Industry <input type="checkbox"/> Irrigation <input type="checkbox"/> Air conditioning <input type="checkbox"/> Stock <input type="checkbox"/> Lawn <input type="checkbox"/> Oil field water <input type="checkbox"/> Other			
LIME "Grayish"	5 12	9. Casing: Material <input type="checkbox"/> Height: Above or below Threaded <input type="checkbox"/> Welded <input type="checkbox"/> Surface 2 1/4 in. RMP <input type="checkbox"/> PVC <input checked="" type="checkbox"/> Weight 50 lbs./ft. Dia. 5 in. to 144 ft. depth Wall Thickness: inches or Dia. 5 in. to 144 ft. depth Gage No. 258			
CLAY "yellow"	12 14	10. Screen: Manufacturer's name <input type="checkbox"/> Type PVC #40 Dia. 5 Slot/gauze 10 25 Length 10' Set between 13 1 ft. and 144 ft. ft. and <input type="checkbox"/> ft. Gravel pack? <input type="checkbox"/> Size range of material <input type="checkbox"/>			
LIME	14 34	11. Static water level: mo./day/yr. 34 ft. below land surface Date 10-12-77			
SHALE "Blueish"	34 69	12. Pumping level below land surfaces: ft. after hrs. pumping g.p.m. ft. after hrs. pumping g.p.m. Estimated maximum yield 2 g.p.m.			
LIME some water	69 84	13. Water sample submitted: mo./day/yr. Yes <input checked="" type="checkbox"/> No <input type="checkbox"/> Date <input type="checkbox"/>			
SHALE Grayish	84 88	14. Well head completion: Pitless adapter 74 Inches above grade			
SHALE Blueish	88 112	15. Well grouted? <input type="checkbox"/> <input type="checkbox"/> Land owner With: <input type="checkbox"/> Neat cement <input type="checkbox"/> Bentonite <input type="checkbox"/> Concrete Depth: From ft. to ft.			
CLAY Redish	112 116	16. Nearest source of possible contamination: ft. 500 Direction WEST Type ST Well disinfected upon completion? <input checked="" type="checkbox"/> Yes <input type="checkbox"/> No			
SHALE Gray	116 138	17. Pump: <input checked="" type="checkbox"/> Not installed Manufacturer's name <input type="checkbox"/> Model number <input type="checkbox"/> HP <input type="checkbox"/> Volts <input type="checkbox"/> Length of drop pipe ft. capacity g.p.m. Type: <input type="checkbox"/> Submersible <input type="checkbox"/> Turbine <input type="checkbox"/> Jet <input type="checkbox"/> Reciprocating <input type="checkbox"/> Centrifugal <input type="checkbox"/> Other			
CLAY "Redish" gravel to 138	138 144				
SHALE gray	144				
(Use a second sheet if needed)					
18. Elevation:	19. Remarks: Land owner put in own well grout & cement well & told him the law	20. Water well contractor's certification: This well was drilled under my jurisdiction and this report is true to the best of my knowledge and belief. B & S well Drill 335 Business name <input type="checkbox"/> License No. <input type="checkbox"/> Address <input type="checkbox"/> <input type="checkbox"/> Date 11-877 Signed <input type="checkbox"/> <input type="checkbox"/> Authorized representative <input type="checkbox"/>			
Topography: <input type="checkbox"/> Hill <input checked="" type="checkbox"/> Slope <input type="checkbox"/> Upland <input type="checkbox"/> Valley					