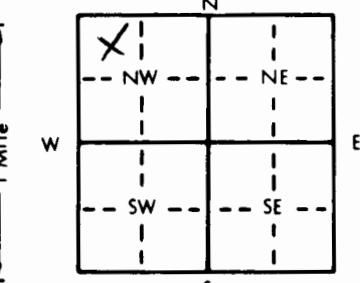


1 LOCATION OF WATER WELL:		Fraction 1/4	NW 1/4 NW 1/4	Section Number 28	Township Number T 26 S	Range Number R 5 EW	
Distance and direction from nearest town or city street address of well if located within city? <b>5 MILES SOUTH OF EL DORADO</b>	
2 WATER WELL OWNER: <b>BUTLER COUNTY LANDFILL</b> RR#, St. Address, Box #: <b>COUNTY ENGINEER, BUTLER CO. COURTHOUSE</b> City, State, ZIP Code: <b>EL DORADO, KANSAS 67042</b>	
3 LOCATE WELL'S LOCATION WITH AN "X" IN SECTION BOX: 	
4 DEPTH OF COMPLETED WELL: <b>28.5</b> ft. ELEVATION: <b>1297.65 TOC</b> Depth(s) Groundwater Encountered <b>21.5</b> ft. 2. ft. 3. ft. WELL'S STATIC WATER LEVEL <b>21.5</b> ft. below land surface measured on mo/day/yr <b>11-2-93</b> Pump test data: Well water was ft. after hours pumping gpm Est. Yield gpm: Well water was ft. after hours pumping gpm Bore Hole Diameter <b>6</b> in. to <b>30</b> ft., and in. to ft. WELL WATER TO BE USED AS: 5 Public water supply 8 Air conditioning 11 Injection well 1 Domestic 3 Feedlot 6 Oil field water supply 9 Dewatering 12 Other (Specify below) 2 Irrigation 4 Industrial 7 Lawn and garden only 10 Monitoring well Was a chemical/bacteriological sample submitted to Department? Yes <b>No</b> ; If yes, mo/day/yr sample was submitted Water Well Disinfected? Yes <b>No</b>	
5 TYPE OF BLANK CASING USED: 1 Steel 3 RMP (SR) 5 Wrought iron 8 Concrete tile Casing Joints: Glued Clamped 2 PVC 4 ABS 6 Asbestos-Cement 9 Other (specify below) Welded Blank casing diameter <b>2</b> in. to <b>18.5</b> ft., Dia in. to ft., Dia in. to ft. Casing height above land surface <b>42</b> in., weight lbs./ft. Wall thickness or gauge No. <b>SCHEDULE 40</b>	
TYPE OF SCREEN OR PERFORATION MATERIAL: 1 Steel 3 Stainless steel 5 Fiberglass 8 RMP (SR) 10 Asbestos-cement 2 Brass 4 Galvanized steel 6 Concrete tile 9 ABS 11 Other (specify) SCREEN OR PERFORATION OPENINGS ARE: 1 Continuous slot 3 Mill slot 5 Gauzed wrapped 8 Saw cut 11 None (open hole) 2 Louvered shutter 4 Key punched 6 Wire wrapped 9 Drilled holes 7 Torch cut 10 Other (specify)	
SCREEN-PERFORATED INTERVALS: From <b>18.5</b> ft. to <b>28.5</b> ft., From ft. to ft., From ft. to ft. From ft. to ft., From ft. to ft., From ft. to ft. GRAVEL PACK INTERVALS: From <b>14</b> ft. to <b>28.5</b> ft., From ft. to ft., From ft. to ft. From ft. to ft., From ft. to ft., From ft. to ft.	
6 GROUT MATERIAL: 1 <b>Neat cement</b> 2 Cement grout 3 Bentonite 4 Other Grout Intervals: From <b>0</b> ft. to <b>14</b> ft., From ft. to ft., From ft. to ft., From ft. to ft. What is the nearest source of possible contamination: 1 Septic tank 4 Lateral lines 7 Pit privy 10 Livestock pens 14 Abandoned water well 2 Sewer lines 5 Cess pool 8 Sewage lagoon 11 Fuel storage 15 Oil well/Gas well 3 Watertight sewer lines 6 Seepage pit 9 Feedyard 12 Fertilizer storage 16 Other (specify below) <b>LANDFILL</b>	
Direction from well? <table border="1"><thead><tr><th>FROM</th><th>TO</th><th>LITHOLOGIC LOG</th><th>FROM</th><th>TO</th><th>PLUGGING INTERVALS</th></tr></thead><tbody><tr><td>0</td><td>2.5</td><td>FAT CLAY, DARK REDDISH BROWN, MOIST, STIFF</td><td></td><td></td><td></td></tr><tr><td>2.5</td><td>5.0</td><td>SANDY CLAY, REDDISH BROWN, MOIST, STIFF</td><td></td><td></td><td></td></tr><tr><td>5.0</td><td>6.5</td><td>GRAVELLY CLAY, DARK REDDISH BROWN, WET, STIFF</td><td></td><td></td><td></td></tr><tr><td>6.5</td><td>8.0</td><td>INTERBEDDED LIMESTONE AND SHALE</td><td></td><td></td><td></td></tr><tr><td>8.0</td><td>11.0</td><td>SHALE, LIGHT GRAY, HARD</td><td></td><td></td><td></td></tr><tr><td>11.0</td><td>11.5</td><td>LIMESTONE</td><td></td><td></td><td></td></tr><tr><td>11.5</td><td>14.0</td><td>SHALE</td><td></td><td></td><td></td></tr><tr><td>14.0</td><td>15.0</td><td>LIMESTONE</td><td></td><td></td><td></td></tr><tr><td>15.0</td><td>18.0</td><td>SHALE</td><td></td><td></td><td></td></tr><tr><td>18.0</td><td>30.0</td><td>LIMESTONE, TAN, VERY HARD, THIN ALTERNATING SHALE SEAMS</td><td></td><td></td><td></td></tr>

7 CONTRACTOR'S OR LANDOWNER'S CERTIFICATION: This water well was (1) <b>constructed</b> (2) reconstructed, or (3) plugged under my jurisdiction and was completed on (mo/day/year) <b>10-26-93</b> and this record is true to the best of my knowledge and belief. Kansas Water Well Contractor's License No. <b>524</b> This Water Well Record was completed on (mo/day/yr) <b>1-3-94</b> under the business name of <b>ALLIED ENVIRONMENTAL CONSULTANTS</b> by (signature) <b>William H. Keltner, President</b>						
---	--	--	--	--	--	--