

1 LOCATION OF WATER WELL: County: BUTLER	Fraction $\frac{1}{4}$ NW $\frac{1}{4}$ NW $\frac{1}{4}$	Section Number 28	Township Number T 26 S	Range Number R 5 EW
--	---	-----------------------------	----------------------------------	--------------------------------------


Distance and direction from nearest town or city street address of well if located within city?

5 MILES SOUTH OF EL DORADO

MW-1

2	WATER WELL OWNER:	BUTLER COUNTY LANDFILL	Board of Agriculture, Division of Water Resources Application Number:
	RR#, St. Address, Box #	COUNTY ENGINEER, BUTLER CO. COURTHOUSE	
	City, State, ZIP Code	EL DORADO, KANSAS 67042	

3	LOCATE WELL'S LOCATION WITH AN "X" IN SECTION BOX:	4	DEPTH OF COMPLETED WELL.....21 ft. ELEVATION: 1267.47 TOC
---	--	---	---

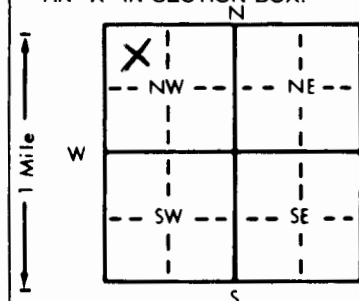

4 DEPTH OF COMPLETED WELL..... 21 ft. ELEVATION: 1267.47 TOC

Depth(s) Groundwater Encountered 1. 8.9 ft. 2. ft. 3. ft.

WELL'S STATIC WATER LEVEL 8.9 ft. below land surface measured on mo/day/yr 11/2/93

Pump test data: Well water was ft. after hours pumping gpm

Est. Yield gpm: Well water was ft. after hours pumping gpm

Bore Hole Diameter..... 6 in. to 23 ft., and in. to ft.

WELL WATER TO BE USED AS:

1 Domestic	3 Feedlot	6 Oil field water supply	9 Dewatering	11 Injection well
2 Irrigation	4 Industrial	7 Lawn and garden only	10 Monitoring well	12 Other (Specify below)

Was a chemical/bacteriological sample submitted to Department? Yes..... No.....; If yes, mo/day/yr sample was sub-
mitted..... Water Well Disinfected? Yes..... No.....

5 TYPE OF BLANK CASING USED:

1 Steel	3 RMP (SR)	5 Wrought iron	8 Concrete tile	CASING JOINTS: Glued Clamped
<u>2 PVC</u>	4 ABS	6 Asbestos-Cement	9 Other (specify below)	Welded Threaded
Blank casing diameter <u>2</u> in. to <u>6</u> ft., Dia in. to ft., Dia				
Casing height above land surface <u>36</u> in., weight lbs./ft.				Wall thickness or gauge No. <u>SCHEDULE 40</u>

TYPE OF SCREEN OR PERFORATION MATERIAL:

1 Steel	3 Stainless steel	5 Fiberglass	8 RMP (SR)	10 Asbestos-cement
2 Brass	4 Galvanized steel	6 Concrete tile	9 ABS	11 Other (specify)
				12 None used (open hole)

SCREEN OR PERFORATION OPENINGS ARE:

1 Continuous slot	<u>Mill slot</u>	5 Gauzed wrapped	8 Saw cut	11 None (open hole)
2 Louvered shutter	4 Key punched	6 Wire wrapped	9 Drilled holes	
		7 Torch cut	10 Other (specify)	

SCREEN-PERFORATED INTERVALS:

From <u>6</u> ft. to <u>21</u> ft., From ft. to ft.
From ft. to ft., From ft. to ft.

GRAVEL PACK INTERVALS:

From <u>3</u> ft. to <u>21</u> ft., From ft. to ft.
From ft. to ft., From ft. to ft.

6 GROUT MATERIAL: 1 Neat cement 2 Cement grout 3 Bentonite 4 Other

Grout Intervals: From 0 ft. to 3 ft. From ft. to ft. From ft. to ft. From ft. to ft.

What is the nearest source of possible contamination:

1 Septic tank	4 Lateral lines	7 Pit privy	10 Livestock pens	14 Abandoned water well
2 Sewer lines	5 Cess pool	8 Sewage lagoon	11 Fuel storage	15 Oil well/Gas well
3 Watertight sewer lines	6 Seepage pit	9 Feedyard	12 Fertilizer storage	16 Other (specify below)
			13 Insecticide storage	LANDFILL

Direction from well? How many feet?

[illegible]

7 CONTRACTOR'S OR LANDOWNER'S CERTIFICATION: This water well was (1) constructed, (2) reconstructed, or (3) plugged under my jurisdiction and was completed on (mo/day/year) 10-26-93 and this record is true to the best of my knowledge and belief. Kansas Water Well Contractor's License No. 524 This Water Well Record was completed on (mo/day/yr) 1-3-94 under the business name of ALLIED ENVIRONMENTAL CONSULTANTS by (signature) William H. Kethron Resident