

## MW17

Range Number


R 5  E  W

211 E. Central  
El Dorado, KS 67042

☐ Other .....Bore Hole Diameter: ..... in. to ..... ft. and  
..... in. to ..... ft.

13. ☐ Other (specify): .....


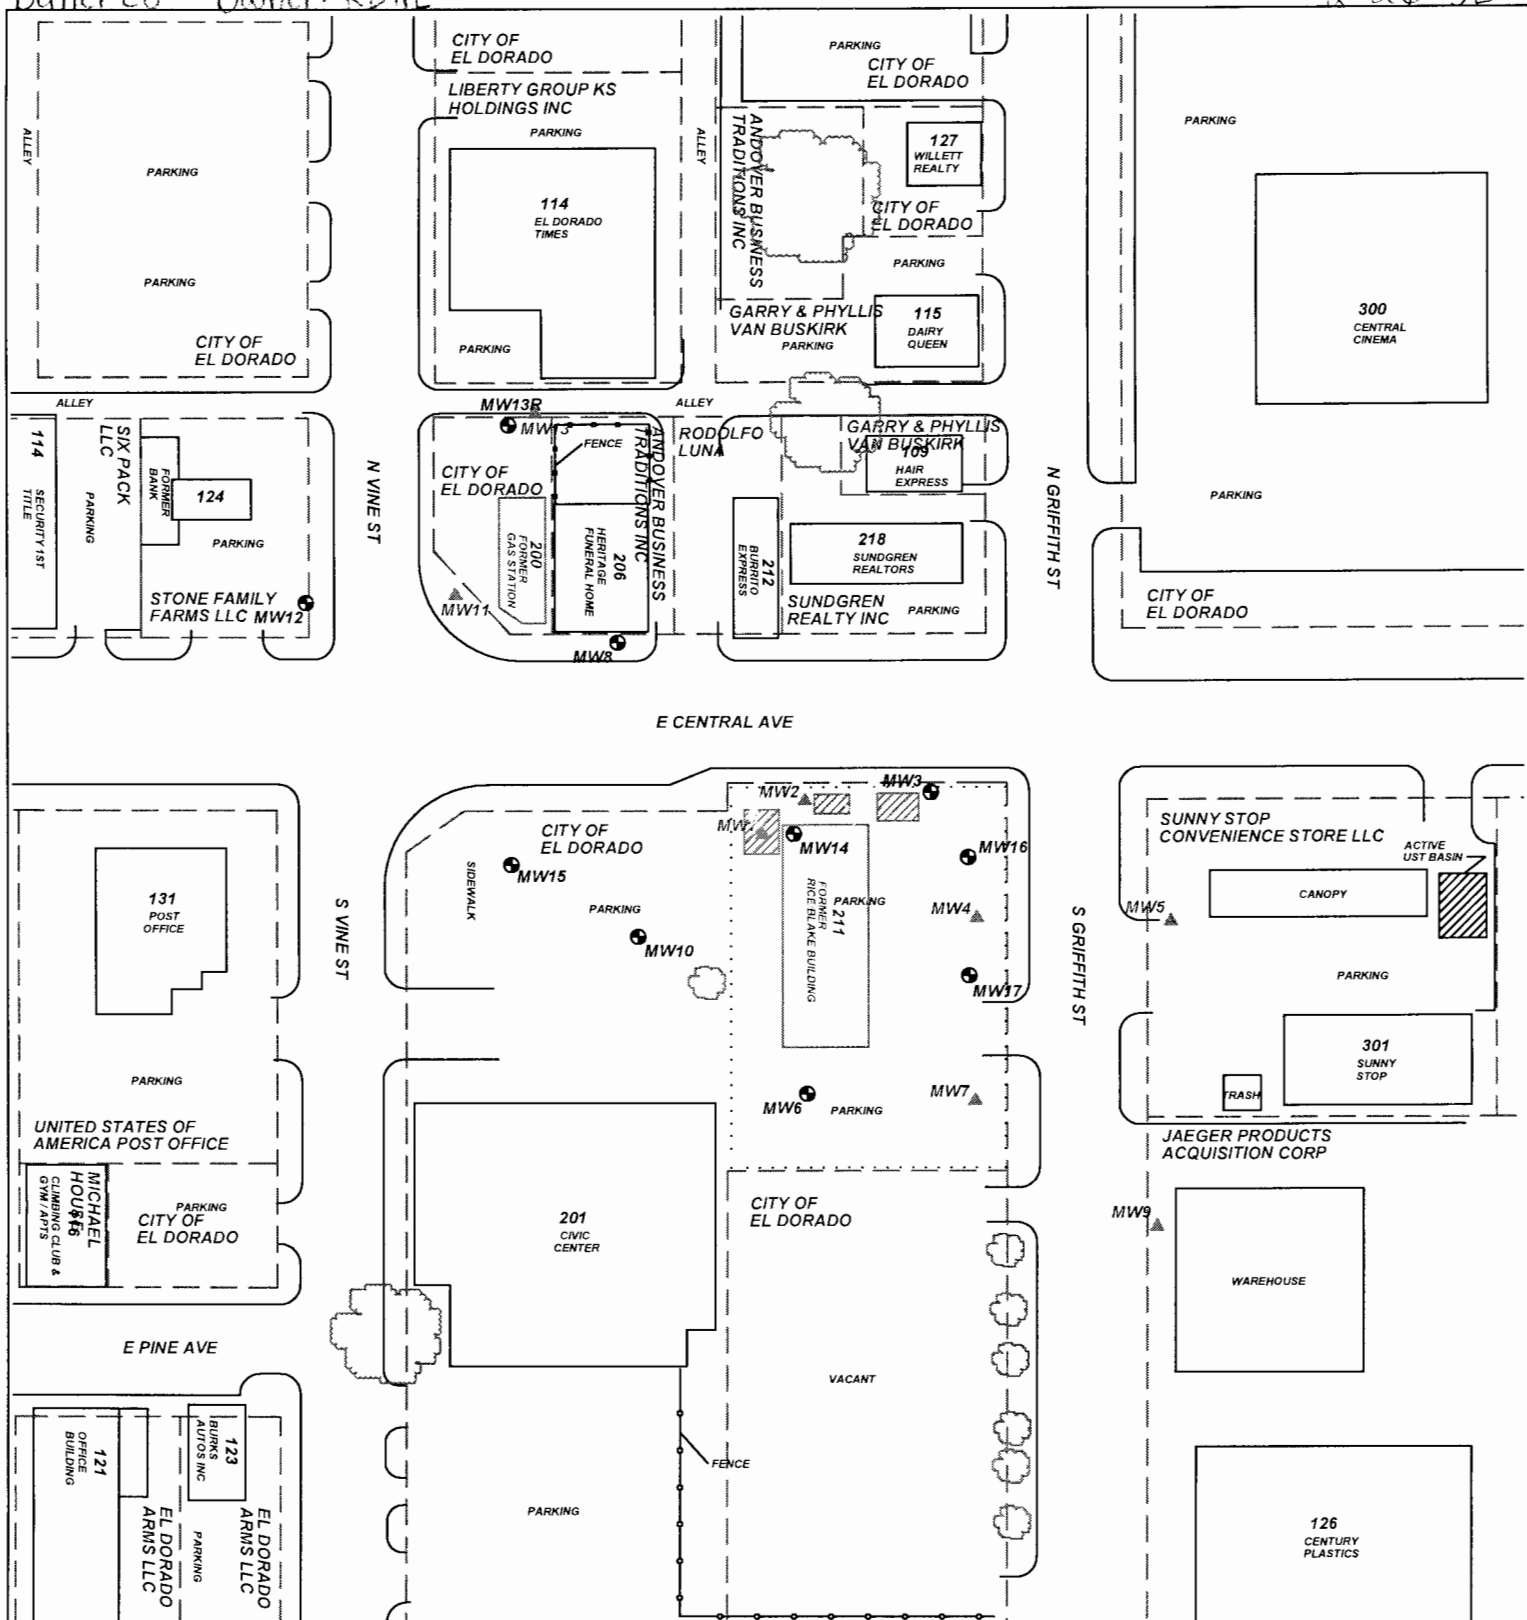

PROJECT: **RICE/BLAKE BUILDING**

ADDRESS: **211 E. CENTRAL**

LOCATION: **EL DORADO, KS**

DRAWN BY: **C. ROE** DATE: **5/8/18**

REVISED BY: **C. ROE** DATE: **6/15/18**

AEI JOB # **TF272** KDHE JOB # **U2-008-00187**

SCALE: **1" = 100'**  
  
 0 50 100

NOTES:  
 No basements observed within 500'.

TITLE: **FIGURE 2.2  
 AREA BASE MAP  
 350' RADIUS**



**ASSOCIATED  
 ENVIRONMENTAL  
 INC.**

LEGEND:  
 = FORMER UST LOCATIONS  
 = MONITORING WELL  
 ..... = SUBJECT PROPERTY  
 --- = PARCEL BOUNDARY

