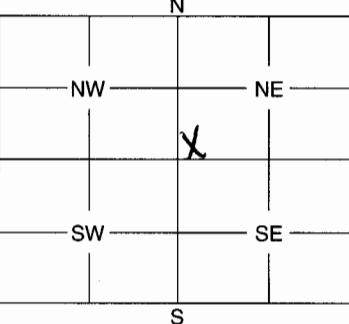


1	LOCATION OF WATER WELL: County: Butter	Fraction SW 1/4 NW 1/4 NE 1/4	Section Number 19	Township Number 26	Range Number 6	_____	
2	WATER WELL OWNER: RR #, St. Address, Box #: City, State, ZIP Code	Distance and direction from nearest town or city street address of well if located within city? CITY OF SEDORADO IS 3 MILES NORTHWEST					
	PO BOX 792 CITY OF SEDORADO KS 67042	Board of Agriculture, Division of Water Resources Application Number: MW2					
3	MARK WELL'S LOCATION WITH AN "X" IN SECTION BOX:	4	DEPTH OF WELL 12 ft.				
			WELL'S STATIC WATER LEVEL 4.82 ft.				
			WELL WAS USED AS:				
			1 Domestic 2 Irrigation 3 Feedlot 4 Industrial	5 Public Water Supply 6 Oil Field Water Supply 7 Domestic (Lawn & Garden) 8 Air Conditioning	9 Dewatering 10 Monitoring Well 11 Injection Well 12 Other		
			Was a chemical / bacteriological sample submitted to Department? Yes X No ✓				
			If yes, mo/day/yr sample was submitted				
			Water Well Disinfected: Yes X No				
5	TYPE OF BLANK CASING USED:						
	1 Steel 2 PVC	3 RMP (SR)	5 Wrought	7 Fiberglass	9 Other (Specify below)		
			4 ABS	6 Asbestos-Cement	8 Concrete Tile		
	Blank casing diameter 2 in. Was casing pulled? Yes X No ✓ If yes, how much 12'						
	Casing height above or below land surface 0 in.						
6	GROUT PLUG MATERIAL: 1 Neat cement 2 Cement grout 3 Bentonite 4 Other						
	Grout Plug Intervals: From 3 ft. to 15 ft., From ft. to ft., From ft. to ft.						
	What is the nearest source of possible contamination:						
	1 Septic tank 2 Sewer lines 3 Watertight sewer lines 4 Lateral lines 5 Cess pool	6 Seepage pit 7 Pit privy 8 Sewage lagoon 9 Feedyard 10 Livestock pens	11 Fuel storage 12 Fertilizer storage 13 Insecticide storage 14 Abandoned water well 15 Oil well/Gas well	16 Other (specify below)			
	Direction from well? W How many feet? 5-10						
	FROM	TO	PLUGGING MATERIALS				
	0	3	Soil				
	3	15	Bentonite				
7	CONTRACTOR'S OR LANDOWNER'S CERTIFICATION: This water well was plugged under my jurisdiction and was completed on (mo/day/year) 6/24/05 and this record is true to the best of my knowledge and belief. Kansas Water Well Contractor's License No. 757 This Water Well Record was completed on (mo/day/year) 6/29/05 under the business name of Larsen + Associates, Inc. by (signature) Kelly Munro						

INSTRUCTIONS: Use typewriter or ball point pen. Please press firmly and print clearly. Please fill in blanks, underline or circle the correct answers. Send top three copies to Kansas Department of Health and Environment, Bureau of Water, Geology Section, 1000 SW Jackson St., Ste. 420, Topeka, Kansas 66612-1367. Telephone: 785/296-5522. Send one to Water Well Owner and retain one for your records.