

WATER WELL RECORD Form WWC-5 KSA 82a-1212

1 LOCATION OF WATER WELL:

Fraction

SW $\frac{1}{4}$ NW $\frac{1}{4}$ NE $\frac{1}{4}$

Section Number

19

Township Number

T 06

Range Number

R 6

County: Butler

S

NW

Distance and direction from nearest town or city street address of well if located within city?

City of El Dorado is 3 miles northwest

2 WATER WELL OWNER: City of El Dorado

RR#, St. Address, Box # P.O. Box 792

Board of Agriculture, Division of Water Resources

City, State, ZIP Code


El Dorado, KS 67042

Application Number:

Mw 7

1371-14

3 LOCATE WELL'S LOCATION WITH AN "X" IN SECTION BOX:

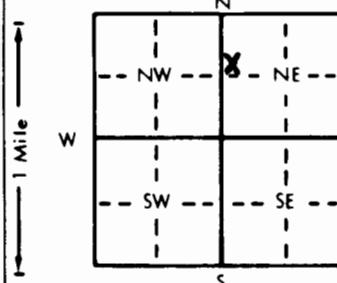

4 DEPTH OF COMPLETED WELL: 12 ft. ELEVATION: 1371.14' Ground

Depth(s) Groundwater Encountered 1364.55 ft. 2 ft. 3 ft. ft.

WELL'S STATIC WATER LEVEL 1364.55 ft. below land surface measured on mo/day/yr 2/9/98

Pump test data: Well water was ft. after hours pumping gpm

Est. Yield gpm: Well water was ft. after hours pumping gpm

Bore Hole Diameter 8 in. to 15 ft. and in. to ft.

WELL WATER TO BE USED AS: 5 Public water supply 8 Air conditioning 11 Injection well

1 Domestic 3 Feedlot 6 Oil field water supply 9 Dewatering 12 Other (Specify below)

2 Irrigation 4 Industrial 7 Lawn and garden only 10 Monitoring well

Was a chemical/bacteriological sample submitted to Department? Yes No X If yes, mo/day/yr sample was submitted

Water Well Disinfected? Yes No

5 TYPE OF BLANK CASING USED:

1 Steel 3 RMP (SR)
CPVC 4 ABS

5 Wrought iron

8 Concrete tile

CASING JOINTS: Glued Clamped

6 Asbestos-Cement
7 Fiberglass

9 Other (specify below)

Welded

Threaded ✓

Blank casing diameter 2 in. to 2 ft. Dia in. to ft. in. to ft.

Casing height above land surface 12 in., weight lbs./ft. Wall thickness or gauge No.

TYPE OF SCREEN OR PERFORATION MATERIAL:

1 Steel 3 Stainless steel
2 Brass 4 Galvanized steel

5 Fiberglass

6 Concrete tile

CPVC

10 Asbestos-cement

11 Other (specify)

12 None used (open hole)

SCREEN OR PERFORATION OPENINGS ARE:

1 Continuous slot 2 Mill slot
2 Louvered shutter 4 Key punched

5 Gauzed wrapped

6 Wire wrapped

7 Torch cut

8 Saw cut

11 None (open hole)

9 Drilled holes

10 Other (specify)

SCREEN-PERFORATED INTERVALS: From 12 ft. to 2 ft. From ft. to ft. From ft. to ft.

From ft. to ft. From ft. to ft. From ft. to ft.

GRAVEL PACK INTERVALS: From 12 ft. to 2 ft. From ft. to ft. From ft. to ft.

From ft. to ft. From ft. to ft. From ft. to ft.

6 GROUT MATERIAL: 1 Neat cement 2 Cement grout 3 Bentonite 4 Other

Grout Intervals: From 2 ft. to 0 ft., From ft. to ft., From ft. to ft., From ft. to ft.

What is the nearest source of possible contamination:

1 Septic tank 4 Lateral lines
2 Sewer lines 5 Cess pool
3 Watertight sewer lines 6 Seepage pit7 Pit privy
8 Sewage lagoon
9 Feedyard

10 Livestock pens

14 Abandoned water well

11 Fuel storage

15 Oil well/Gas well

12 Fertilizer storage

16 Other (specify below)

13 Insecticide storage

Direction from well?

East

How many feet? 10

LITHOLOGIC LOG

FROM	TO	LITHOLOGIC LOG	FROM	TO	PLUGGING INTERVALS
0	5'	Black silty clay w/major iron veins, organics, no odor, dry, friable			
5	6'	SAA but brown in color			
6	15'	Tan limestone w/silty clay matrix, petro odor, sand traces, soft, fractured, weathered			

7 CONTRACTOR'S OR LANDOWNER'S CERTIFICATION: This water well was (1) constructed, (2) reconstructed, or (3) plugged under my jurisdiction and was completed on (mo/day/year) Jan 27 98 and this record is true to the best of my knowledge and belief. Kansas

Water Well Contractor's License No. 634 This Water Well Record was completed on (mo/day/yr) March 6 98

under the business name of Shady EN. Testing LLC by (signature) Murphie