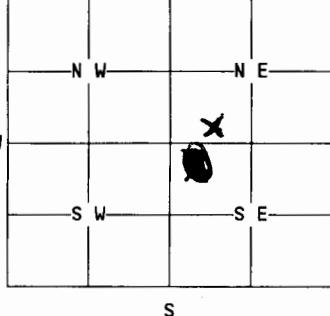


1	LOCATION OF WATER WELL:	Fraction	Section Number	Township Number	Range Number												
County: BUTLER S 1/2 SW 1/4 NE 1/4		1/4	34	36 26	6												
Distance and direction from nearest town or city street address of well if located within city? 4 NORTH AND 1/2 EAST OF LEON, KS																	
2	WATER WELL OWNER:	ORVILLE CARVER															
RR#, St. Address, Box #:		11947 S.W. SANTA FE LAKE ROAD															
City, State, ZIP Code :		AUGUSTA, KS 67010															
Board of Agriculture, Division of Water Resources Application Number:																	
3	MARK WELL'S LOCATION WITH AN "X" IN SECTION BOX: N	4 DEPTH OF WELL..... 50' ft. WELL'S STATIC WATER LEVEL 23' ft. WELL WAS USED AS: <table border="0"> <tr> <td>1 Domestic</td> <td>5 Public Water Supply</td> <td>9 Dewatering</td> </tr> <tr> <td>2 Irrigation</td> <td>6 Oil Field Water Supply</td> <td>10 Monitoring Well</td> </tr> <tr> <td>3 Feedlot</td> <td>7 Lawn and Garden Only</td> <td>11 Injection Well</td> </tr> <tr> <td>4 Industrial</td> <td>8 Air Conditioning</td> <td>12 Other.....</td> </tr> </table>				1 Domestic	5 Public Water Supply	9 Dewatering	2 Irrigation	6 Oil Field Water Supply	10 Monitoring Well	3 Feedlot	7 Lawn and Garden Only	11 Injection Well	4 Industrial	8 Air Conditioning	12 Other.....
1 Domestic	5 Public Water Supply	9 Dewatering															
2 Irrigation	6 Oil Field Water Supply	10 Monitoring Well															
3 Feedlot	7 Lawn and Garden Only	11 Injection Well															
4 Industrial	8 Air Conditioning	12 Other.....															
	 W E																
5	Was a chemical/bacteriological sample submitted to Department? Yes... NO ... If yes, mo/day/yr sample was submitted.....																
	Water Well Disinfected: Yes No.....																
5	TYPE OF BLANK CASING USED:																
1 Steel 3 RMP (SR) 5 Wrought 7 Fiberglass 9 Other (specify below) 2 PVC 4 ABS 6 Asbestos-Cement 8 Concrete Tile																	
Blank casing diameter..... 4 in. Was casing pulled? Yes..... No..... If yes, how much.....																	
Casing height above or below land surface.... 3' in.																	
6	GROUT PLUG MATERIAL: 1 Neat cement 2 Cement grout 3 Bentonite 4 Other.....																
Grout Plug Intervals: From.....ft. to.....ft., From.....ft. toft., From..... to.....ft.																	
What is the nearest source of possible contamination:																	
1 Septic tank 6 Seepage pit 11 Fuel storage 16 Other (specify below) 2 Sewer lines 7 Pit privy 12 Fertilizer storage 3 Watertight sewer lines 8 Sewage lagoon 13 Insecticide storage 4 Lateral lines 9 Feedyard 14 Abandoned water well 5 Cess Pool 10 Livestock pens 15 Oil well/Gas well																	
Direction from well? How many feet?																	
FROM	TO	PLUGGING MATERIALS															
WELL WAS CAPPED WITH WELDED STEEL PLATE 3' ABOVE GROUND																	
7	CONTRACTOR'S OR LANDOWNER'S CERTIFICATION: This water well was plugged under my jurisdiction and was completed on (mo/day/year) 10/12/98 and this record is true to the best of my knowledge and belief. Kansas Water Well Contractor's license No. This Water Well Record was completed on (mo/day/year) under the business name of F.L.AT. H.LLCS. INCORP. by (signature) Paul J. Jones																
INSTRUCTIONS: Use typewriter or ball point pen. Please press firmly and print clearly. Please fill in blanks, underline or circle the correct answers. Send top three copies to Kansas Department of Health and Environment, Bureau of Water, Topeka, Kansas 66620-0001. Telephone: 913/296-3565. Send one to Water Well Owner and retain one for your records.																	