

1 LOCATION OF WATER WELL:

Fraction NE 1/4 NE 1/4 NW 1/4Section Number 8Township Number T-26 - SRange Number R - 6 - ECounty: Butler

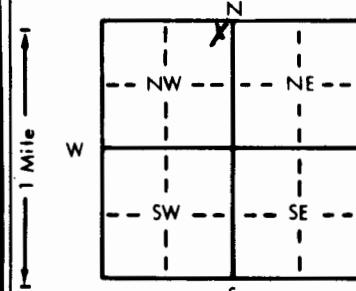
Distance and direction from nearest town or city street address of well if located within city?

2 1/2 miles east of El Dorado, Ks. on Highway 54 just south side25 or 26?2 WATER WELL OWNER: Harlan SEEBERRR#, St. Address, Box #: Rural Route #2City, State, ZIP Code: El Dorado, Kansas 67042

Board of Agriculture, Division of Water Resources

Application Number:

3 LOCATE WELL'S LOCATION WITH AN "X" IN SECTION BOX:

4 DEPTH OF COMPLETED WELL 155' ft. ELEVATION: _____Depth(s) Groundwater Encountered 1. 60' ft. 2. 110' ft. 3. ft.WELL'S STATIC WATER LEVEL 45' ft. below land surface measured on mo/day/yr

Pump test data: Well water was _____ ft. after _____ hours pumping _____ gpm

Est. Yield 50 gpm Well water was _____ ft. after _____ hours pumping _____ gpmBore Hole Diameter 11 in. to 155' ft., and _____ in. to _____ ft.

WELL WATER TO BE USED AS: 5 Public water supply 8 Air conditioning 11 Injection well

1 Domestic 3 Feedlot 6 Oil field water supply 9 Dewatering 12 Other (Specify below)

2 Irrigation 4 Industrial 7 Lawn and garden only 10 Observation well

Was a chemical/bacteriological sample submitted to Department? Yes _____ No X If yes, mo/day/yr sample was submittedWater Well Disinfected? Yes X No

5 TYPE OF BLANK CASING USED:

1 Steel 2 PVC 3 RMP (SR) 4 ABS

5 Wrought iron

6 Asbestos-Cement

7 Fiberglass

8 Concrete tile

9 Other (specify below)

CASING JOINTS: Glued _____ Clamped _____

Welded _____

Threaded _____

SDR 26Blank casing diameter 8 in. to 155' ft., Dia _____ in. to _____ ft.Casing height above land surface 12' in., weight 180 lbs./ft. Wall thickness or gauge No. _____

TYPE OF SCREEN OR PERFORATION MATERIAL:

1 Steel 3 Stainless steel 5 Fiberglass 7 PVC

2 Brass 4 Galvanized steel 6 Concrete tile

5 Gauzed wrapped

6 Wire wrapped

8 RMP (SR)

9 ABS

10 Asbestos-cement

11 Other (specify) _____

12 None used (open hole)

11 None (open hole)

SCREEN OR PERFORATION OPENINGS ARE:

1 Continuous slot 3 Mill slot 5 Gauzed wrapped

2 Louvered shutter 4 Key punched 6 Wire wrapped

SCREEN-PERFORATED INTERVALS: From 75' ft. to 155' ft., From _____ ft. to _____ ft.From 75' ft. to 155' ft., From _____ ft. to _____ ft.GRAVEL PACK INTERVALS: From 15' ft. to 155' ft., From _____ ft. to _____ ft.From 15' ft. to 155' ft., From _____ ft. to _____ ft.

6 GROUT MATERIAL: 1 Neat cement 2 Cement grout 3 Bentonite 4 Other _____

Grout Intervals: From 3 ft. to 15' ft., From _____ ft. to _____ ft., From _____ ft. to _____ ft.

What is the nearest source of possible contamination:

1 Septic tank 4 Lateral lines 7 Pit privy 10 Livestock pens 14 Abandoned water well

2 Sewer lines 5 Cess pool 8 Sewage lagoon 11 Fuel storage 15 Oil well/Gas well

3 Watertight sewer lines 6 Seepage pit 9 Feedyard 12 Fertilizer storage 16 Other (specify below)

Direction from well?

SouthHow many feet? 150'

FROM TO LITHOLOGIC LOG FROM TO LITHOLOGIC LOG

0	3	Soil	0	3	Soil
3	10	Clay	3	10	Clay
10	95	Limestone (water 60')	10	95	Limestone (water 60')
95	100	Shale	95	100	Shale
100	105	Red Bed	100	105	Red Bed
105	125	Limestone (water 110')	105	125	Limestone (water 110')
125	130	Shale	125	130	Shale
130	140	Red Bed	130	140	Red Bed
140	145	Shale	140	145	Shale
145	155	Limestone	145	155	Limestone

7 CONTRACTOR'S OR LANDOWNER'S CERTIFICATION: This water well was 1 constructed, 2 reconstructed, or 3 plugged under my jurisdiction and was completed on (mo/day/year) 7/4/81 and this record is true to the best of my knowledge and belief. KansasWater Well Contractor's License No. 413 This Water Well Record was completed on (mo/day/year) 7/25/81 by (signature) Thomas J. Phillipsunder the business name of Tumble Weed Drilling

INSTRUCTIONS: Use typewriter or ball point pen, PLEASE PRESS FIRMLY and PRINT clearly. Please fill in blanks, underline or circle the correct answers. Send top three copies to Kansas Department of Health and Environment, Division of Environment, Environmental Geology Section, Topeka, KS 66620. Send one to WATER WELL OWNER and retain one for your records.