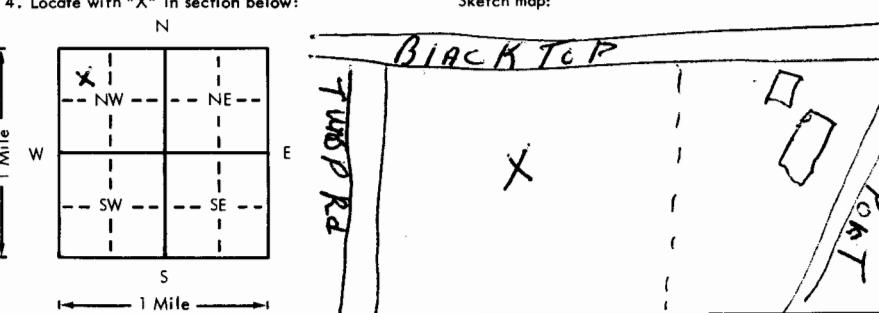


1. Location of well:	County Butler	Fraction NW 1/4 NW 1/4 NW 1/4	Section number 19	Township number T 26 S R 6	Range number E/4
2. Distance and direction from nearest town or city: 2 miles S of El Dorado, Ks on Hwy 54 Then 1/4 East	3. Owner of well: Dick DeVore	R.R. or street: PO Box 132	City, state, zip code: WICHITA, KANSAS		
4. Locate with "X" in section below: 			5. Type and color of material		
			From	To	
TOP SOIL			0	3	
Lime rock			3	30	
SHALE Grayish			30	93	
Lime			93	107	
SHALE Grayish			107	120	
Lime			120	126	
SHALE Grayish			126	152	
CLAY Red Bed			152	161	
SHALE Gray			161	170	
(Use a second sheet if needed)					
18. Elevation:	19. Remarks:				
Topography: <input type="checkbox"/> Hill <input type="checkbox"/> Slope <input checked="" type="checkbox"/> Upland <input type="checkbox"/> Valley					
20. Water well contractor's certification: This well was drilled under my jurisdiction and this report is true to the best of my knowledge and belief. Butler Well Drilling 335 Business name Address Rte 1 Box 132 El Dorado, Ks Signed Butler Well Drilling Date 10-1-77 Authorized representative					