

1 LOCATION OF WATER WELL:

Fraction

NW $\frac{1}{4}$ NE $\frac{1}{4}$ NE $\frac{1}{4}$

Section Number

Township Number

Range Number

County: *Butcher*

26

T 26 S

R 6

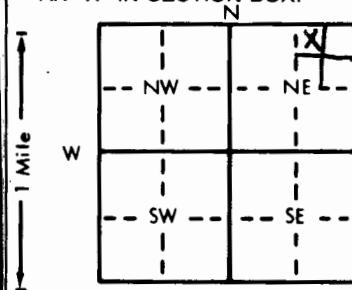
E

Distance and direction from nearest town or city street address of well if located within city? *6N 2 3/4 E of Leavenworth*2 WATER WELL OWNER: *Jerry Hamlin*RR#, St. Address, Box #: *1926 West Towanda Apt 2*City, State, ZIP Code: *El Dorado KS 67042*

Board of Agriculture, Division of Water Resources

Application Number:

3 LOCATE WELL'S LOCATION WITH AN "X" IN SECTION BOX:

4 DEPTH OF COMPLETED WELL *99* ft. ELEVATION: *Slope*Depth(s) Groundwater Encountered *1 58* ft. 2. ft. 3. ft.WELL'S STATIC WATER LEVEL *19* ft. below land surface measured on mo/day/yr *4-23-82*

Pump test data: Well water was ft. after hours pumping gpm

Est. Yield gpm: Well water was ft. after hours pumping gpm

Bore Hole Diameter *8* in. to *99* ft., and in. to ft.

WELL WATER TO BE USED AS: 5 Public water supply 8 Air conditioning 11 Injection well

1 Domestic 3 Feedlot 6 Oil field water supply 9 Dewatering 12 Other (Specify below)

2 Irrigation 4 Industrial 7 Lawn and garden only 10 Observation well

Was a chemical/bacteriological sample submitted to Department? Yes No If yes, mo/day/yr sample was submittedWater Well Disinfected? Yes No

5 TYPE OF BLANK CASING USED:

1 Steel 3 RMP (SR)
 PVC 4 ABS5 Wrought iron 8 Concrete tile
6 Asbestos-Cement 9 Other (specify below)CASING JOINTS: Glued Clamped
Welded Threaded Blank casing diameter *5* in. to *79* ft., Dia in. to ft., Dia in. to ft.Casing height above land surface *12* in., weight lbs./ft. Wall thickness or gauge No. *160.16*

TYPE OF SCREEN OR PERFORATION MATERIAL:

1 Steel 3 Stainless steel
2 Brass 4 Galvanized steel5 Fiberglass 8 RMP (SR)
6 Concrete tile 9 ABS10 Asbestos-cement
11 Other (specify)
12 None used (open hole)

SCREEN OR PERFORATION OPENINGS ARE:

1 Continuous slot 3 Mill slot
2 Louvered shutter 4 Key punched5 Gauzed wrapped 6 Wire wrapped
7 Torch cut8 Saw cut 11 None (open hole)
9 Drilled holes
10 Other (specify)SCREEN-PERFORATED INTERVALS: From *79* ft. to *99* ft., From ft. to ft., From ft. to ft.

From ft. to ft., From ft. to ft., From ft. to ft.

GRAVEL PACK INTERVALS: From *79* ft. to *14* ft., From ft. to ft., From ft. to ft.

From ft. to ft., From ft. to ft., From ft. to ft.

6 GROUT MATERIAL: 1 Neat cement 2 Cement grout 3 Bentonite 4 OtherGrout Intervals: From *14* ft. to *3* ft., From ft. to ft., From ft. to ft., From ft. to ft.What is the nearest source of possible contamination: *open field*

- | | | | | |
|--------------------------|-----------------|-----------------|-----------------------|--------------------------|
| 1 Septic tank | 4 Lateral lines | 7 Pit privy | 10 Livestock pens | 14 Abandoned water well |
| 2 Sewer lines | 5 Cess pool | 8 Sewage lagoon | 11 Fuel storage | 15 Oil well/Gas well |
| 3 Watertight sewer lines | 6 Seepage pit | 9 Feedyard | 12 Fertilizer storage | 16 Other (specify below) |

Direction from well?

FROM	TO	LITHOLOGIC LOG	FROM	TO	LITHOLOGIC LOG
0	1	Top soil			
1	6	Clay brown			
6	26	Limestone yellow			
26	42	Shale gray			
42	80	Limestone yellow/grey			
8	99	Shale gray green			

7 CONTRACTOR'S OR LANDOWNER'S CERTIFICATION: This water well was constructed, (2) reconstructed, or (3) plugged under my jurisdiction and was completed on (mo/day/year) *4-23-82* and this record is true to the best of my knowledge and belief. KansasWater Well Contractor's License No. *363* This Water Well Record was completed on (mo/day/year) *4-23-82*under the business name of *Braddy Water Wells* by (signature) *Richard Braddy*

INSTRUCTIONS: Use typewriter or ball point pen, PLEASE PRESS FIRMLY and PRINT clearly. Please fill in blanks, underline or circle the correct answers. Send top three copies to Kansas Department of Health and Environment, Division of Environment, Environmental Geology Section, Topeka, KS 66620. Send one to WATER WELL OWNER and retain one for your records.