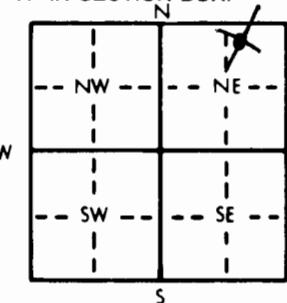


WATER WELL RECORD Form WWC-5 KSA 82a-1212

1 LOCATION OF WATER WELL:		Fraction County: Butler	NE $\frac{1}{4}$ NE $\frac{1}{4}$ NE $\frac{1}{4}$	Section Number 26	Township Number T 26 S	Range Number R 6 E	
Distance and direction from nearest town or city street address of well if located within city? 6 Miles East & 3 Miles South of El Dorado, KS							
2 WATER WELL OWNER:		Robert Cooley					Board of Agriculture, Division of Water Resources
RR#, St. Address, Box #:		Rt 2					Application Number:
City, State, ZIP Code:		El Dorado, KS 67042					
3 LOCATE WELL'S LOCATION WITH AN "X" IN SECTION BOX:		4 DEPTH OF COMPLETED WELL 150 ft. ELEVATION:					
		Depth(s) Groundwater Encountered 1 ft. 2 ft. 3 ft. WELL'S STATIC WATER LEVEL ft. below land surface measured on mo/day/yr 1.1-29-94 Pump test data: Well water was ft. after hours pumping gpm Est. Yield gpm: Well water was ft. after hours pumping gpm Bore Hole Diameter 5 in. to 15.8 ft., and in. to ft. WELL WATER TO BE USED AS: 5 Public water supply 8 Air conditioning 11 Injection well 1 Domestic 3 Feedlot 6 Oil field water supply 9 Dewatering 12 Other (Specify below) 2 Irrigation 4 Industrial 7 Lawn and garden only 10 Monitoring well Heat Pump Holes Was a chemical/bacteriological sample submitted to Department? Yes No X; If yes, mo/day/yr sample was submitted Water Well Disinfected? Yes X No					
5 TYPE OF BLANK CASING USED:		5 Wrought iron	8 Concrete tile	CASING JOINTS: Glued			Clamped
1 Steel		3 RMP (SR)	6 Asbestos-Cement	9 Other (specify below)			Welded
2 PVC		4 ABS	7 Fiberglass	Polyethylene			Threaded
Blank casing diameter 3/4"		in. to 15.0 ft.	Dia	in. to ft.			Dia in. to ft.
Casing height above land surface							lbs./ft. Wall thickness or gauge No.
TYPE OF SCREEN OR PERFORATION MATERIAL:		7 PVC	10 Asbestos-cement				
1 Steel		3 Stainless steel	5 Fiberglass	8 RMP (SR)	11 Other (specify) NA		
2 Brass		4 Galvanized steel	6 Concrete tile	9 ABS	12 None used (open hole)		
SCREEN OR PERFORATION OPENINGS ARE:		5 Gauzed wrapped	8 Saw cut	11 None (open hole)			
1 Continuous slot		3 Mill slot	6 Wire wrapped	9 Drilled holes			
2 Louvered shutter		4 Key punched	7 Torch cut	10 Other (specify) NA			
SCREEN-PERFORATED INTERVALS: From		ft. to NA	ft.	From	ft.	ft. to	ft.
From		ft. to	ft.	From	ft.	ft. to	ft.
GRAVEL PACK INTERVALS: From		ft. to	ft.	From	ft.	ft. to	ft.
From		ft. to	ft.	From	ft.	ft. to	ft.
6 GROUT MATERIAL:		1 Neat cement	2 Cement grout	3 Bentonite	4 Other		
Grout Intervals:		From 0 ft. to 150 ft.	From ft. to ft.	From ft. to ft.	From ft. to ft.		
What is the nearest source of possible contamination:		7 Pit privy	10 Livestock pens	14 Abandoned water well			
1 Septic tank		4 Lateral lines	11 Fuel storage	15 Oil well/Gas well			
2 Sewer lines		5 Cess pool	12 Fertilizer storage	16 Other (specify below)			
3 Watertight sewer lines		6 Seepage pit	9 Feedyard	13 Insecticide storage			
Direction from well? West		How many feet? 150 ft					
FROM	TO	LITHOLOGIC LOG		FROM	TO	PLUGGING INTERVALS	
0	2	Top Soil					
2	8	Brown Clay					
8	62	Limestone					
62	80	Gray Shale					
80	110	Limestone					
110	119	Red Shale					
119	135	Gray Shale					
135	158	Hard Rock					
4 holes at 150ft							

7 CONTRACTOR'S OR LANDOWNER'S CERTIFICATION: This water well was (1) constructed, (2) reconstructed, or (3) plugged under my jurisdiction and was completed on (mo/day/year) 1.1-29-94 and this record is true to the best of my knowledge and belief. Kansas Water Well Contractor's License No. 1.38. This Water Well Record was completed on (mo/day/yr) 1.2-13-94 under the business name of Peterson Irrigation Inc. by (signature) *Mike Peterson*