

CORRECTION(S) TO WATER WELL RECORD (WWC-5)

(to rectify lacking or incorrect information)

County: BUTLER

Location listed as:

Section-Township-Range: 13

Fraction ($\frac{1}{4}$ $\frac{1}{4}$ $\frac{1}{4}$): SE NE

Location changed to:

13 - 26S - 7E

SE NE

Other changes: Initial statements: _____

Changed to: _____

Comments: _____

verification method: Butler Co ownership map and directions from Driller

initials: JSB date: 8-31-04

submitted by: Kansas Geological Survey, Data Resources Library, 1930 Constant Ave., Lawrence, KS 66047-3726
to: Kansas Dept of Health & Environment, Bureau of Water, 1000 SW Jackson, Suite 420, Topeka, KS 66612-1367.


1 LOCATION OF WATER WELL:	Fraction 1/4 SE 1/4 NE 1/4	Section Number 13	Township Number T	Range Number S
County: Butler				E/W

Distance and direction from nearest town or city street address of well if located within city?

INTERSECTION OF SE 20TH & SE GRAY RD. ROSALIA, KS

2 WATER WELL OWNER:	MAGELLAN PIPELINE COMPANY, LLC	Board of Agriculture, Division of Water Resources
RR#, St. Address, Box #	ONE WILLIAMS CENTER	Application Number:
City, State, ZIP Code	TULSA, OK 74172	

3 LOCATE WELL'S LOCATION WITH AN "X" IN SECTION BOX:	4 DEPTH OF COMPLETED WELL ft. ELEVATION:
--	--

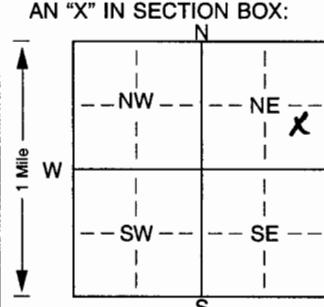

Depth(s) Groundwater Encountered 1. ft. 2. ft. 3. ft.
WELL'S STATIC WATER LEVEL ft. below land surface measured on mo/day/yr
Pump test data: Well water was ft. after hours pumping gpm
Est. Yield gpm: Well water was ft. after hours pumping gpm
Bore Hole Diameter. B in. to ft., and in. to ft.
WELL WATER TO BE USED AS: 5 Public water supply 8 Air conditioning 11 Injection well
1 Domestic 3 Feedlot 6 Oil field water supply 9 Dewatering 12 Other (Specify below)
2 Irrigation 4 Industrial 7 Domestic (lawn & garden) 10 Monitoring well

Was a chemical/bacteriological sample submitted to Department? Yes. No.	
If yes, mo/day/yr sample was submitted	Water Well Disinfected? Yes No

5 TYPE OF BLANK CASING USED:	5 Wrought iron 8 Concrete tile CASING JOINTS: Glued. Clamped.
1 Steel 3 RMP (SR) 6 Asbestos-Cement 9 Other (specify below) Welded.	
2 PVC 4 ABS 7 Fiberglass Threaded.	

Blank casing diameter in. to ft., Dia in. to ft., Dia in. to ft.

Casing height above land surface in., weight lbs./ft. Wall thickness or gauge No. **40**

TYPE OF SCREEN OR PERFORATION MATERIAL:	7 PVC 10 Asbestos-cement
1 Steel 3 Stainless steel 5 Fiberglass 8 RMP (SR) 11 Other (specify)	
2 Brass 4 Galvanized steel 6 Concrete tile 9 ABS 12 None used (open hole)	

SCREEN OR PERFORATION OPENINGS ARE:	5 Gauzed wrapped 8 Saw cut 11 None (open hole)
1 Continuous slot 3 Mill slot 6 Wire wrapped 9 Drilled holes	
2 Louvered shutter 4 Key punched 7 Torch cut 10 Other (specify) ft.	

SCREEN-PERFORATED INTERVALS: From. ft. to ft., From. ft. to ft.

GRAVEL PACK INTERVALS: From. ft. to ft., From. ft. to ft.

From. ft. to ft., From. ft. to ft.

From. ft. to ft., From. ft. to ft.

From. ft. to