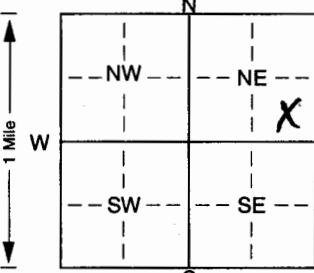
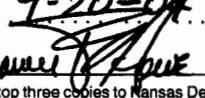


1 LOCATION OF WATER WELL:	Fraction County: <b>BUTLER</b>	SG $\frac{1}{4}$ SE $\frac{1}{4}$ NE $\frac{1}{4}$	Section Number 13	Township Number T 26 S	Range Number R 7 E	
Distance and direction from nearest town or city street address of well if located within city? <b>INTERSECTION OF 28 SE 20TH &amp; SE Gray Rd., ROSAUA, KS</b>						
2 WATER WELL OWNER:	<b>MABELIAN PIPELINE COMPANY, LLC</b>		Board of Agriculture, Division of Water Resources			
RR#, St. Address, Box #	<b>ONE WILLIAMS CENTER</b>		Application Number:			
City, State, ZIP Code	<b>TULSA, OK 74172</b>					
3 LOCATE WELL'S LOCATION WITH AN "X" IN SECTION BOX:	4 DEPTH OF COMPLETED WELL..... <b>12.0'</b> ft. ELEVATION: .....					
 Depth(s) Groundwater Encountered 1..... ft. 2..... ft. 3..... ft. WELL'S STATIC WATER LEVEL..... ft. below land surface measured on mo/day/yr Pump test data: Well water was ..... ft. after ..... hours pumping ..... gpm Est. Yield ..... gpm; Well water was ..... ft. after ..... hours pumping ..... gpm Bore Hole Diameter..... <b>8</b> in. to ..... ft. and ..... in. to ..... ft. E WELL WATER TO BE USED AS: 5 Public water supply 8 Air conditioning 11 Injection well 1 Domestic 3 Feedlot 6 Oil field water supply 9 Dewatering 12 Other (Specify below) 2 Irrigation 4 Industrial 7 Domestic (lawn & garden) <b>10</b> Monitoring well Was a chemical/bacteriological sample submitted to Department? Yes. .... No. ....; If yes, mo/day/yr sample was submitted Water Well Disinfected? Yes No						
5 TYPE OF BLANK CASING USED:	1 Steel <b>2 PVC</b>	3 RMP (SR) 4 ABS	5 Wrought iron 6 Asbestos-Cement 7 Fiberglass	8 Concrete tile 9 Other (specify below)	CASING JOINTS: Glued..... Clamped..... Welded..... <b>Threaded</b>	
Blank casing diameter	<b>2 1/2"</b> in. to ..... ft., Dia ..... in. to ..... ft., Dia ..... in. to ..... ft.					
Casing height above land surface	<b>30'</b> in., weight ..... lbs./ft. Wall thickness or gauge No. <b>40</b>					
TYPE OF SCREEN OR PERFORATION MATERIAL:	1 Steel 2 Brass	3 Stainless steel 4 Galvanized steel	5 Fiberglass 6 Concrete tile	7 PVC 8 RMP (SR) 9 ABS	10 Asbestos-cement 11 Other (specify) ..... 12 None used (open hole)	
SCREEN OR PERFORATION OPENINGS ARE:	1 Continuous slot 2 Louvered shutter	3 Mill slot 4 Key punched	5 Gauzed wrapped 6 Wire wrapped 7 Torch cut	8 Saw cut 9 Drilled holes 10 Other (specify) .....	11 None (open hole)	
SCREEN-PERFORATED INTERVALS:	From. .... <b>12.0'</b> ft. to ..... ft.	From. .... <b>3.5'</b> ft. to ..... ft.	From. .... ft. to ..... ft.	From. .... ft. to ..... ft.	From. .... ft. to ..... ft.	
GRAVEL PACK INTERVALS:	From. .... <b>12'</b> ft. to ..... ft.	From. .... <b>7.5'</b> ft. to ..... ft.	From. .... ft. to ..... ft.	From. .... ft. to ..... ft.	From. .... ft. to ..... ft.	
6 GROUT MATERIAL:	1 Neat cement	2 Cement grout	3 Bentonite	4 Other ..... <b>Concrete</b>		
Grout Intervals:	From. .... <b>1.0'</b> ft. to ..... ft.	From. .... ft. to ..... ft.	From. .... ft. to ..... ft.	From. .... ft. to ..... ft.	From. .... ft. to ..... ft.	
What is the nearest source of possible contamination:	1 Septic tank 2 Sewer lines 3 Watertight sewer lines	4 Lateral lines 5 Cess pool 6 Seepage pit	7 Pit privy 8 Sewage lagoon 9 Feedyard	10 Livestock pens 11 Fuel storage 12 Fertilizer storage 13 Insecticide storage	14 Abandoned water well 15 Oil well/Gas well 16 Other (specify below) .....	
Direction from well?	How many feet?					
FROM	TO	LITHOLOGIC LOG		FROM	TO	PLUGGING INTERVALS
<b>0</b>	<b>5.8</b>	<b>BLACK SILTY CLAY</b>				
<b>5.8</b>	<b>9.6</b>	<b>DK. GRAY CHERT W/CLAY</b>				
<b>9.6</b>	<b>11.0</b>	<b>CLAY W/CHERT AND W/THICKENED LIMESTONE</b>				
<b>11.0</b>	<b>12.0</b>	<b>LIMESTONE W/CHERT</b>				
<b>MW-09</b> <b>2x3 Concrete Pad</b> <b>w/ 3 Post + 4' well Cover</b>						
7 CONTRACTOR'S OR LANDOWNER'S CERTIFICATION:	This water well was <b>(1)</b> constructed, <b>(2)</b> reconstructed, or <b>(3)</b> plugged under my jurisdiction and was completed on (mo/day/year) <b>9-14-04</b> and this record is true to the best of my knowledge and belief. Kansas Water Well Contractor's Licence No. <b>529</b> This Water Well Record was completed on (mo/day/yr) <b>9-20-04</b>					
under the business name of <b>GEOTECHNOLOGY, INC.</b>	by (signature) 					
INSTRUCTIONS: Use typewriter or ball point pen. <b>PLEASE PRESS FIRMLY</b> and <b>PRINT</b> clearly. Please fill in blanks, underline or circle the correct answers. Send up three copies to Kansas Department of Health and Environment, Bureau of Water, Topeka, Kansas 66620-0001. Telephone 785-296-5524. Send one to WATER WELL OWNER and retain one for your records. Fee of \$5.00 for each constructed well.						

7 CONTRACTOR'S OR LANDOWNER'S CERTIFICATION: This water well was (1) constructed, (2) reconstructed, or (3) plugged under my jurisdiction and was completed on (mo/day/year) 9-14-04 and this record is true to the best of my knowledge and belief. Kansas Water Well Contractor's Licence No. 529 This Water Well Record was completed on (mo/day/yr) 9-20-04 by (signature) ST

INSTRUCTIONS: Use typewriter or ball point pen. PLEASE PRESS FIRMLY and PRINT clearly. Please fill in blanks, underline or circle the correct answers. Send top three copies to Kansas Department of Health and Environment, Bureau of Water, Topeka, Kansas 66620-0001. Telephone 785-296-5524. Send one to WATER WELL OWNER and retain one for your records. Fee of \$5.00 for each constructed well.