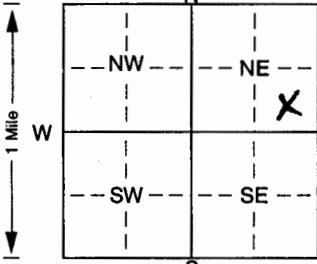


1 LOCATION OF WATER WELL:	Fraction County: BUTLER	SE $\frac{1}{4}$ SE $\frac{1}{4}$ NE $\frac{1}{4}$	Section Number 13	Township Number T 26 S	Range Number R 7 E
---------------------------	-----------------------------------	--	----------------------	---------------------------	-----------------------

Distance and direction from nearest town or city street address of well if located within city?

INTERSECTION OF SE 20TH & SE Gray Rd. ROSAUA, KS

2 WATER WELL OWNER:	MAZOLAN PIPELINE COMPANY, LLC			Board of Agriculture, Division of Water Resources
RR#, St. Address, Box #	ONE WILLIAMS CENTER			Application Number:
City, State, ZIP Code	TULSA, OK 74172			

3 LOCATE WELL'S LOCATION WITH AN "X" IN SECTION BOX:	4 DEPTH OF COMPLETED WELL..... 16.0' ft. ELEVATION:
	Depth(s) Groundwater Encountered 1..... ft. 2..... ft. 3..... ft. WELL'S STATIC WATER LEVEL..... ft. below land surface measured on mo/day/yr
	Pump test data: Well water was ft. after hours pumping gpm Est. Yield gpm. Well water was ft. after hours pumping gpm Bore Hole Diameter. in. to ft. and. in. to ft.
	WELL WATER TO BE USED AS: 5 Public water supply 8 Air conditioning 11 Injection well 1 Domestic 3 Feedlot 6 Oil field water supply 9 Dewatering 12 Other (Specify below) 2 Irrigation 4 Industrial 7 Domestic (lawn & garden) 10 Monitoring well
	Was a chemical/bacteriological sample submitted to Department? Yes. No.; If yes, mo/day/yr sample was submitted Water Well Disinfected? Yes No CASING JOINTS: Glued. Clamped. Welded. Threaded.

5 TYPE OF BLANK CASING USED:	5 Wrought iron	8 Concrete tile	CASING JOINTS: Glued. Clamped.
1 Steel	6 Asbestos-Cement	9 Other (specify below)	Welded.
2 PVC	7 Fiberglass		Threaded

Blank casing diameter **2"** in. to ft. Dia in. to ft. Dia in. to ft.Casing height above land surface. **30"** in., weight lbs./ft. Wall thickness or gauge No. **40** ft.

TYPE OF SCREEN OR PERFORATION MATERIAL:

1 Steel	3 Stainless steel	5 Fiberglass	8 RMP (SR)	10 Asbestos-cement
2 Brass	4 Galvanized steel	6 Concrete tile	9 ABS	11 Other (specify)
				12 None used (open hole)

SCREEN OR PERFORATION OPENINGS ARE:

1 Continuous slot	3 Mill slot	5 Gauzed wrapped	8 Saw cut	11 None (open hole)
2 Louvered shutter	4 Key punched	6 Wire wrapped	9 Drilled holes	
		7 Torch cut	10 Other (specify)	ft.

SCREEN-PERFORATED INTERVALS: From. **16.0'** ft. to **6.0'** ft. From ft. to ft.

From. ft. to ft. From ft. to ft.

GRAVEL PACK INTERVALS: From. **16.0'** ft. to **4.0'** ft. From ft. to ft.

From. ft. to ft. From ft. to ft.

Bent. Seal

6 GROUT MATERIAL: 1 Neat cement 2 Cement grout 3 Bentonite 4 Other **Concrete**Grout Intervals: From. **1.0'** ft. to **0'** ft., From ft. to ft., From ft. to ft.

What is the nearest source of possible contamination:

1 Septic tank	4 Lateral lines	7 Pit privy	10 Livestock pens	14 Abandoned water well
2 Sewer lines	5 Cess pool	8 Sewage lagoon	11 Fuel storage	15 Oil well/Gas well
3 Watertight sewer lines	6 Seepage pit	9 Feedyard	12 Fertilizer storage	16 Other (specify below)

Direction from well?

FROM	TO	LITHOLOGIC LOG	FROM	TO	PLUGGING INTERVALS
0	7.1	BROWN SILTY CLAY			
7.1	15.0	CHERT W/ CLAY			
15.0	16	YELLOW BROWN CLAY AND SILTY WEATHERED LIMESTONE			

MW-10

**2x2 Concrete pad
w/ 3 Post Around well
+ 4" Well Cover**

7 CONTRACTOR'S OR LANDOWNER'S CERTIFICATION: This water well was (1) constructed, (2) reconstructed, or (3) plugged under my jurisdiction and was completed on (mo/day/year) **9-13-04** and this record is true to the best of my knowledge and belief. KansasWater Well Contractor's Licence No. **529** This Water Well Record was completed on (mo/day/yr) **9-20-04**
under the business name of **GEO TECHNOLOGY, INC.** by (signature) 