

1) LOCATION OF WATER WELL:

Fraction

NE $\frac{1}{4}$ SW $\frac{1}{4}$ NE $\frac{1}{4}$

Section Number

Township Number

Range Number

County: Butler
Distance and direction from nearest town or city street address of well if located within city?

3W 3S of Rosalia

2) WATER WELL OWNER:

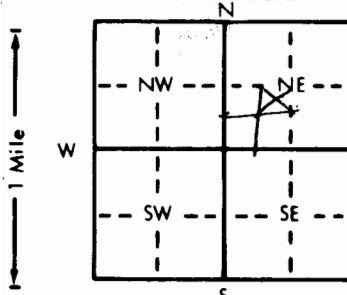
B E Thomas 67042

Board of Agriculture, Division of Water Resources

RR#, St. Address, Box #

City, State, ZIP Code RR2 Eldorado Kan

Application Number:

3) LOCATE WELL'S LOCATION WITH
AN "X" IN SECTION BOX:

4) DEPTH OF COMPLETED WELL. 200 ft. ELEVATION:

Depth(s) Groundwater Encountered 1. 85 ft. 2. 120 ft. 3. ft.

WELL'S STATIC WATER LEVEL 75 ft. below land surface measured on mo/day/yr

Pump test data: Well water was ft. after hours pumping gpm

Est. Yield 2 gpm: Well water was ft. after hours pumping gpm

Bore Hole Diameter 8 in. to ft., and in. to ft.

WELL WATER TO BE USED AS: 5 Public water supply 8 Air conditioning 11 Injection well

1 Domestic 3 Feedlot 6 Oil field water supply 9 Dewatering 12 Other (Specify below)

2 Irrigation 4 Industrial 7 Lawn and garden only 10 Observation well

Was a chemical/bacteriological sample submitted to Department? Yes No; If yes, mo/day/yr sample was submitted

Water Well Disinfected? Yes No

5) TYPE OF BLANK CASING USED:

1 Steel 3 RMP (SR)
2 PVC 4 ABS

5 Wrought iron 8 Concrete tile Casing joints: Glued X Clamped

6 Asbestos-Cement 9 Other (specify below) Welded

7 Fiberglass

Threaded

Blank casing diameter 5 in. to 200 ft., Dia. in. to ft., Dia. in. to ft.

Casing height above land surface 18 in., weight 200 lbs./ft. Wall thickness or gauge No. 214

TYPE OF SCREEN OR PERFORATION MATERIAL:

1 Steel 3 Stainless steel
2 Brass 4 Galvanized steel

5 Fiberglass 7 PVC

6 Concrete tile 8 RMP (SR)
9 ABS

10 Asbestos-cement

5 Gauzed wrapped 8 Saw cut 11 None (open hole)

6 Wire wrapped 9 Drilled holes

7 Torch cut 10 Other (specify)

SCREEN OR PERFORATION OPENINGS ARE:

1 Continuous slot 3 Mill slot
2 Louvered shutter 4 Key punched

11 Other (specify)

SCREEN-PERFORATED INTERVALS: From 10 ft. to 90 ft., From ft. to ft., From ft. to ft.

From 110 ft. to 130 ft., From 130 ft. to 180 ft., From 180 ft. to 190 ft.

GRAVEL PACK INTERVALS: From ft. to ft., From ft. to ft., From ft. to ft.

From ft. to ft., From ft. to ft., From ft. to ft.

6) GROUT MATERIAL: 1 Neat cement 2 Cement grout 3 Bentonite 4 Other

Grout Intervals: From 0 ft. to 130 ft., From ft. to ft., From ft. to ft.

What is the nearest source of possible contamination: 10 Livestock pens 14 Abandoned water well

1 Septic tank 4 Lateral lines
2 Sewer lines 5 Cess pool
3 Watertight sewer lines 6 Seepage pit

11 Fuel storage 15 Oil well/Gas well

7 Pit privy 8 Sewage lagoon 12 Fertilizer storage 16 Other (specify below)

9 Feedyard 13 Insecticide storage

How many feet? 175

Direction from well?

FROM TO LITHOLOGIC LOG FROM TO LITHOLOGIC LOG

FROM	TO	LITHOLOGIC LOG	FROM	TO	LITHOLOGIC LOG
0	3	SOIL			
3	8	CLAY			
8	21	ROCK			
21	30	CLAY			
30	51	SHALE			
51	95	LIME			
95	110	SHALE			
110	135	LIME			
135	200	SHALE			


