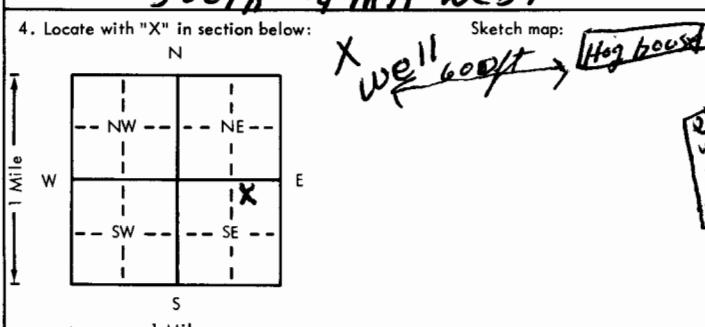


1. Location of well:	County Butler	Fraction NE NN 1/4 NW 1/4 SE 1/4	Section number 26	Township number T 26 S	Range number R 7 E
2. Distance and direction from nearest town or city: Street address of well location if in city:	13 mi E AST OF EL DORADO KS on Hwy 54 THEN 4 mi SOUTH 4 mi WEST		3. Owner of well: Logan White		
			R.R. or street: R 101		
			City, state, zip code: Leon KANSAS 67074		
4. Locate with "X" in section below:			Sketch map:		
	N	E			
	W	S			
	1 Mile				
5. Type and color of material	From	To			
Topsoil	0	6			
gravel	6	21			
Lime	21	26			
SHALE	26	38			
Red Bed CLAY	38	44			
SHALE	44	56			
(Use a second sheet if needed)					
18. Elevation:	19. Remarks:				
Topography: <input type="checkbox"/> Hill <input checked="" type="checkbox"/> Slope <input type="checkbox"/> Upland <input type="checkbox"/> Valley					
20. Water well contractor's certification: This well was drilled under my jurisdiction and this report is true to the best of my knowledge and belief. B&S Drilling 335 Business name B&S EL DORADO KS License No. Address B&S EL DORADO KS Signed Bart Hugoboom Date 6-1-81 Authorized representative					