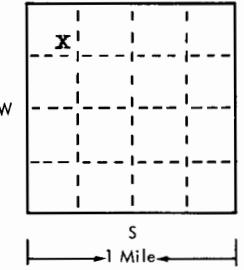
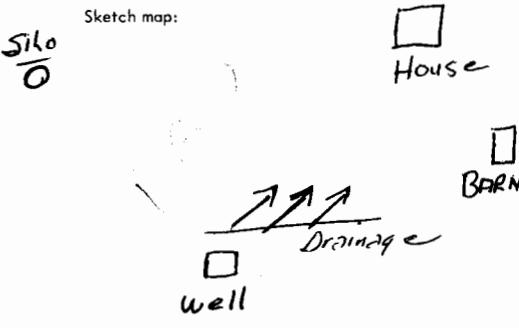


USE TYPEWRITER OR BALL
POINT PEN-PRESS FIRMLY,
PRINT CLEARLY.

T R EW sec 1/4 1/4 1/4 No.

WATER WELL RECORD
KSA 82a-1201-1215

Kansas State Dept. of Health
(Water Well Contractors)
Forbes-Bldg. 740
Topeka, Kansas 66620

1 Location of well:	County BUTLER	Township name GLENCOE	Fraction NW$\frac{1}{4}$ NW$\frac{1}{4}$ NW$\frac{1}{4}$	Section number 33	Town number 26	Range number 7 E
Distance and direction from nearest town or city: 7 E on 96 5.5 n Leom, Ks			3 Owner of well: DAVID JACKMAN Address: Leon, Ks 67074			
Locate with "X" in section below: 			Sketch map: 			
2	Type and color of material		From	To	4 Well depth: 41 ft. Date of completion 10,19,75 Well diameter 8 in.	
	BLACK SOIL		0	1.5	5 <input checked="" type="checkbox"/> Cable tool <input type="checkbox"/> Rotary <input type="checkbox"/> Driven <input type="checkbox"/> Dug <input type="checkbox"/> Hollow rod <input type="checkbox"/> Jetted <input type="checkbox"/> Bored <input type="checkbox"/> Reverse rotary	
	BLACK CLAY		1.5	3.0	6 Use: <input checked="" type="checkbox"/> Domestic <input type="checkbox"/> Public supply <input type="checkbox"/> Industry <input type="checkbox"/> Irrigation <input type="checkbox"/> Air conditioning <input type="checkbox"/> Commercial <input type="checkbox"/> Test well	
	RED CLAY		3.0	14.5	7 Casing: Material Steel Height: above/below Threaded <input type="checkbox"/> Welded <input type="checkbox"/> Surface 18 in. Diam. 28 lbs./ft. in. to ft. depth Drive shoe? <input type="checkbox"/> Yes <input checked="" type="checkbox"/> No in. to ft. depth	
	RED CLAY & GRAVEL		14.5	16.0	8 Screen: Manufacturer None Type _____ Dia. _____ Slot/gauze _____ Length _____ Set between _____ ft. and _____ ft. Fittings: Gravel pack <input type="checkbox"/> Yes <input checked="" type="checkbox"/> No Size range of material _____	
	GRAVEL		16.0	21.0	9 Static water level: ft. below land surface Date _____	
	LIME		21.0	25.0	10 Pumping level below land surfaces: ft. after pumping g.p.m. ft. after pumping g.p.m. Estimated maximum yield 20 g.p.m.	
	SHALE		25.0	41.0	11 Water sample submitted: <input type="checkbox"/> Yes <input checked="" type="checkbox"/> No Date _____	
					12 Well head completion: <input type="checkbox"/> Pitless adapter 48 inches above grade	
					13 Well grouted? <input checked="" type="checkbox"/> Yes <input type="checkbox"/> No <input checked="" type="checkbox"/> Neat cement <input type="checkbox"/> Bentonite _____ Depth: From 2 ft. to 11 ft.	
					14 Nearest source of possible contamination: ft. 500 Direction East Type Barn Well disinfected upon completion? <input checked="" type="checkbox"/> Yes <input type="checkbox"/> No	
					15 Pump: <input checked="" type="checkbox"/> Not installed Manufacturer's name _____ Model number _____ HP _____ Volts _____ Length of drop pipe _____ ft. capacity _____ g.m.p. Type: <input type="checkbox"/> Submersible <input type="checkbox"/> Turbine <input type="checkbox"/> Jet <input type="checkbox"/> Reciprocating <input type="checkbox"/> Centrifugal <input type="checkbox"/> Other	
					16 Remarks: elevation Topography: <input type="checkbox"/> Hill <input type="checkbox"/> Slope <input type="checkbox"/> Upland <input checked="" type="checkbox"/> Valley	
					17 Water well contractor's certification: This well was drilled under my jurisdiction and this report is true to the best of my knowledge and belief. ABRAHAM & PLUMMER 181 Business name Leon, Ks 67074 License No. Address Leon, Ks 67074 Date 10-75 Signature ABRAHAM & PLUMMER Authorized representative	
(use a second sheet if needed)						