


1 LOCATION OF WATER WELL: Fraction SE 1/4 SE 1/4 SE 1/4 Section Number 20 Township Number T 27 S Range Number R 1 E
 County: Sedgwick

Distance and direction from nearest town or city street address of well if located within city?
603 S. Broadway, Wichita, Ks.

2 WATER WELL OWNER: Amoco Oil Co.
 RR#, St. Address, Box #: 8700 Indian Creek Pkwy. Suite 190 Board of Agriculture, Division of Water Resources
 City, State, ZIP Code: Overland Park, Ks. 66210 Application Number:

3 LOCATE WELL'S LOCATION WITH AN "X" IN SECTION BOX:

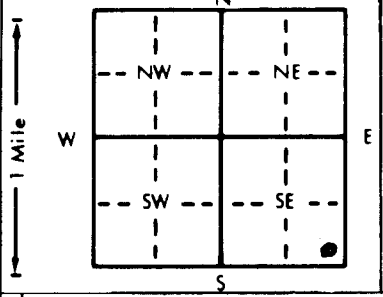

4 DEPTH OF COMPLETED WELL: 23'6" ft. ELEVATION:
 Depth(s) Groundwater Encountered 15'-15 1/2' ft. 2. ft. 3. ft.

WELL'S STATIC WATER LEVEL 14.21 ft. below land surface measured on mo/day/yr 6-22-95

Pump test data: Well water was ft. after hours pumping gpm
 Est. Yield gpm; Well water was ft. after hours pumping gpm
 Bore Hole Diameter: 8 1/2" in. to 23'6" ft., and in. to ft.

WELL WATER TO BE USED AS:
 5 Public water supply 8 Air conditioning 11 Injection well
 1 Domestic 3 Feedlot 6 Oil field water supply 9 Dewatering 12 Other (Specify below)
 2 Irrigation 4 Industrial 7 Lawn and garden only 10 Monitoring well

Was a chemical/bacteriological sample submitted to Department? Yes.....No. X.....; If yes, mo/day/yr sample was submitted
 Water Well Disinfected? Yes No

5 TYPE OF BLANK CASING USED:
 1 Steel 3 RMP (SR) 5 Wrought iron 8 Concrete tile CASING JOINTS: Glued Clamped
2 PVC 4 ABS 6 Asbestos-Cement 9 Other (specify below) Welded

Blank casing diameter 2.375 in. to 13'3" ft., Dia in. to ft., Dia in. to SDR 13 ft.
 Casing height above land surface Flush in., weight lbs./ft. Wall thickness or gauge No. SCH 40

TYPE OF SCREEN OR PERFORATION MATERIAL:
 1 Steel 3 Stainless steel 5 Fiberglass 8 RMP (SR) 10 Asbestos-cement
 2 Brass 4 Galvanized steel 6 Concrete tile 9 ABS 11 Other (specify)

SCREEN OR PERFORATION OPENINGS ARE:
 1 Continuous slot 3 Mill slot 5 Gauzed wrapped 8 Saw cut 11 None (open hole)
 2 Louvered shutter 4 Key punched 6 Wire wrapped 9 Drilled holes

SCREEN-PERFORATED INTERVALS: From 23'6" ft. to 13'3" ft., From ft. to ft.
 GRAVEL PACK INTERVALS: From 23'6" ft. to 11' ft., From ft. to ft.

6 GROUT MATERIAL: 1 Neat cement 2 Cement grout 3 Bentonite 4 Other
 Grout intervals: From 11' ft. to 4' ft., From 4' ft. to 0' ft., From ft. to ft.

What is the nearest source of possible contamination:
 1 Septic tank 4 Lateral lines 7 Pit privy 11 Fuel storage 14 Abandoned water well
 2 Sewer lines 5 Cess pool 8 Sewage lagoon 12 Fertilizer storage 15 Oil well/Gas well
 3 Watertight sewer lines 6 Seepage pit 9 Feedyard 13 Insecticide storage 16 Other (specify below)

Direction from well? South How many feet? 60'

FROM	TO	LITHOLOGIC LOG	FROM	TO	PLUGGING INTERVALS
0	3	Grass-dk brn organic rich silty clay, moist, med.plasticity, firm, earthy odor.			
3	7	Tan brn tight dry clay, caliche, no odor, hard packed, oxide staining.			
7	15	Oxide stained fine grained sand, dry, no odor, well rounded & sorted. Moist to wet at 15'-15 1/2'.			
15	23'6	Fine-coarse grained sand & gravel, wet, no odor, poorly sorted & sub rounded.			

7 CONTRACTOR'S OR LANDOWNER'S CERTIFICATION: This water well was (1) constructed, (2) reconstructed, or (3) plugged under my jurisdiction and was completed on (mo/day/year) 5-6-95 and this record is true to the best of my knowledge and belief. Kansas Water Well Contractor's License No. 539 This Water Well Record was completed on (mo/day/yr) 6-27-95 under the business name of JB Environmental Drilling by (signature) James Beck

OFFICE USE ONLY
T
R
EW
SEC.
1/4
1/4
1/4