
COATION OF WATER WELL  Fraction  Will contage yethin city?  Selection Number  To which Numb	MW-2	23//032	Lwate	R WELL RECORD	) Form W	WC-5 KSA 82a	-1212			
auros and direction from regineed towy or city steres adjectes of yeight libicately within city?  19	LOCATION OF WA	TER WELL:		9(.)	0.1	Section Number	Township Num	ber	Range	_

State, 20 Code  CONTRACTORS OR LANDOWINGERS CEPTIFICATION: This water well was (1) constructed (2) seconstructed, or (3) plugged under my jurisdiction and water well flowwater (3) so water well flower (4) so the construction of the construction o	,	WNER:	od " Deb	ra Stewar	<b>r</b> 7					
COATE WELL'S LOCATION WITH JOSEPH OF COMPLETED WELL  N X' IN SECTION BOX:  WELL'S STATIC WATER LEVEL  In to see the second of the second	•	=		Drive	40		_		Division of Wa	ter Resource
Depthicly Groundwater Encountered M. 2. ft. below land surface measured on modayyr and the Last STATIC MELE STATIC MEREL EVEL M. 1. below land surface measured on modayyr and the Last Static Meles of the Last Static Meles	City, State, ZIP Code	· · · · · · · · · · · · · · · · · · ·	WIChita,	X2 6/9	W8 2/	<				
Depthicly Groundwater Encountered M. 2. ft. below land surface measured on modayyr and the Last STATIC MELE STATIC MEREL EVEL M. 1. below land surface measured on modayyr and the Last Static Meles of the Last Static Meles	LOCATE WELL'S	LOCATION WITH	4 DEPTH OF C	OMPLETED WELL	L <b>26</b> ( )	ft. ELEVA: بَرَيْنِ الْمِ				
Pump test data. Well water was the after hours pumping gon gon. Well water was the after hours pumping gon was under the pumping gon the pumping gon was under the pumping gon the pumping gon was under the pumping gon gon was under the pumping gon gon was under the pumping gon gon gon gon gon gon gon gon gon g	AN A IN SECTIO	N	Depth(s) Ground	lwater Encountered	1 1./	. 🔑 ft. 2				
Well water was fighter hours pumping gone beloe binamers. Bin to be the binamers. Biname	ī !		WELL'S STATIC	WATER LEVEL .	14,02	. ft. below land sur	face measured on n	no/day/yr	6-13	77
Bore hold Diameter S In. to th. and the			Pump	p test data: Well	water was .	ft. a	fter	hours pu	umping	gpn
WELL WATER TO BE USED AS: 5 Public water supply 9 A reconditioning 11 Injection well 1 Domestic 3 Feedbal 6 Oil field water supply 9 Developing 12 Order (Specify below) Was a chemical-bacteriological sample submitted 7 Lawn and garden only (9 Monitoring wsb). Was a chemical-bacteriological sample submitted to Department? Yes. No. It yes, moldayly sample was sumitted Water Well Disnificator 
WELL WATER TO BE USED AS 5 Public water supply 9 Am conditioning 11 Injection well 2 Injection well 3 Feeded 7 Feede	<u>•</u> i		Bore Hole Diame	eter in	. to		and	ir	n. to	
2 Impation 4 Inclustrial 7 Lawn and garden only 60 Menitioning web mitted was a chemical-bacteriological sample submitted to Department? Yes. No. If yes, moldayly sample was sumitted was on the property of	¥ w 1		WELL WATER T	TO BE USED AS:	5 Public	water supply	8 Air conditioning	11	Injection well	
Was a chemical/bacteriological sample submitted to Department 7 ves	-   1		1 Domestic	3 Feedlot	6 Oil fie	eld water supply	9 Dewatering	12	Other (Specify	below)
Imited Water Well Deintecled? Yes No Water Well Deintecled? Yes No Clamped 1 Steel 3 RIMP (SR) 5 Wought ion 8 Concrete tile CASING JOINTS: Glued Clamped 1 Steel 3 RIMP (SR) 6 Asbestos-Cement 9 Other (specify below) Welded 7 RIMP (SP) 1 RIMP (SR) 7 Fiberglass 7 Fiberglass 7 Fiberglass 7 Fiberglass 8 RIMP (SR) 1 Da In 10 In	5W	.  %	2 Irrigation	4 Industrial	7 Lawn	and garden only	10 Monitoring well).			





REEN OR PERFORATION OPENINGS ARE: 1 Continuous sibt (3 Mill sibt) 6 Wire wrapped 9 Drilled holes 2 Cuovered shutter 4 Key punched 7 Torch cut 10 Other (specify) REEN-PERFORATED INTERVALS: From 6. 1t. to 15 ft. From 1t. to				•						
1 Continuous stot 3 Mill slot 2 Louvered shutter 4 Key punched 7 Torch cut 3 5 10 Other (specify) 10 Other (specify) 10 Other (specify) 11 Other (					auzed wrapi	ped		` '	•	en hole)
2 Louvered shutter 4 Key punched 7 Torch cut 3.5 ft. From 1. to		-					9 Drilled holes		` '	,
REEN-PERFORATED INTERVALS: From 6.0 ft. to 5.0 ft. From ft. to 1.0										
From ft. to ft. From ft. To ft			• •	6.5 ft	to 36	5,5ft. From	m	ft.	to	





TO PLUGGING INTERVALS  PROM TO PLUGGING INTERVALS  TO PLUGGING INTERVALS    24 37 . 68 (0)     27 37 . 68 (0)     27 37 . 68 (0)     27 37 . 68 (0)     28 37 . 68 (0)     29 37 . 68 (0)     20 37 . 68 (0)	•	NIA	-3- p.:	- · • • - <b>,</b>			.// 4			
3.0 Clay, Vcry Silty, trace Coarse Grave  O 7.0 Clay, Vcry Silty  Ipt 37.68(0)  Ipng -97.335  CONTRACTOR'S OR LANDOWNER'S CERTIFICATION: This water well was (1) constructed, (2) reconstructed, or (3) plugged under my jurisdiction and wa inpleted on (mo/day/year)  and this record is true to the best of my knowledge and belief. Kansa ter Well Contractor's License No.  This Water Well Record was completed on (mo/day/y)  INSTRUCTIONS. Use typewriter or ball point pen. PLEASE PRIESS FIRMLY and PRINT clearly. Please fill in blanks, underline or circle the correct answers. Send top three copies to Kansas Department		1 , 7 ,	LITHOLOGIC	LOG	FRO			GGING	INTERVALS	





of Health and Environment, Bureau of Water, Topeka, Kansas 66620-0001. Telephone: 913-296-5545. Send one to WATER WELL OWNER and retain one for your records.	INSTRUCTIONS: Use	typewriter or ball point p	oen. PLEASE PRESS F	FIRMLY and PRINT clear	ly. Please fill in I	olanks, underline or circle	the correct answers. Sen	d top three	copies to Kansas	Department

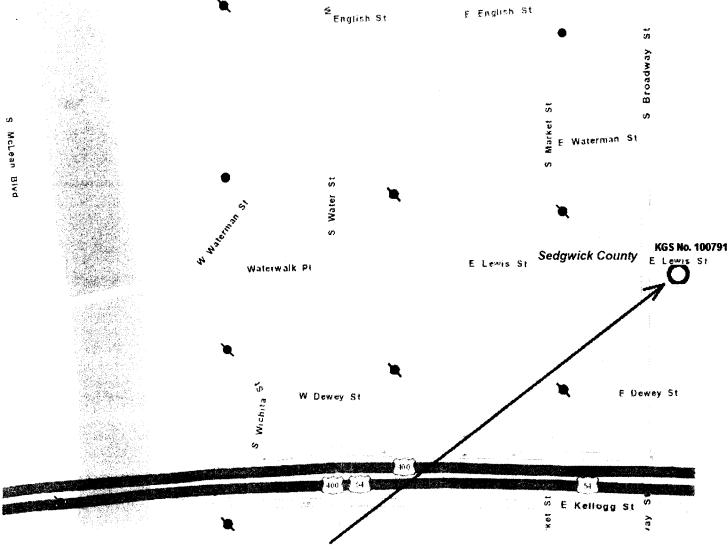

Well T27S, R1E, Sec. 21, SWSWSW, Action: PLUGGED 7/11/2014

