


Water Well Record Form WWC-5 KSA 82a-1212												
1	LOCATION OF WATER WELL:			FRACTION			Section Number		Township Number		Range Number	
	Sedgwick			<del>NE</del> 1/4 <del>NW</del> 1/4 <del>SW</del> 1/4 <i>NW SE NW SW</i>			32		T 27 S		R 1E E/W	

Distance and direction from nearest town or city street address of well if located within city?

**2116 S. Osage      Wichita, Kansas**

2	WATER WELL OWNER:	HOCH, Robert	
	RR#, ST. ADDRESS, BOX #:	10905 W. 1st	Board of Agriculture, Division of Water Resource
	CITY, STATE, ZIP CODE:	Wichita, Kansas	67212 Application Number:

**3 LOCATE WELL'S LOCATION WITH AN "X" IN SECTION BOX:**

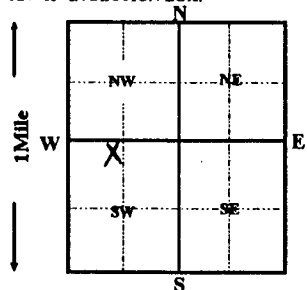

4. DEPTH OF COMPLETED WELL		28	ft.	ELEVATION:		
Depth(s) groundwater Encountered		1	ft.	2	ft.	3
WELL'S STATIC WATER LEVEL		14.5	FT. BELOW LAND SURFACE MEASURED ON		mo/day/yr	07/20/1995
Pump test data:		Well water was	ft.	after	hours pumping	gpm
Est. Yield	gpm:	Well water was	ft.	after	hours pumping	gpm
Bore Hole Diameter	in.	to	ft.	and	in.	to
WELL WATER TO BE USED AS:		5 Public water supply	8 Air conditioning	11 Injection well		
1 Domestic	3 Feedlot	6 Oil field water supply	9 Dewatering	12 Other (Specify below)		
2 Irrigation	4 Industrial	7 Lawn and garden only	10 Monitoring well			
Was a chemical/bacteriological sample submitted to Department? Yes				No <input checked="" type="checkbox"/> ; If yes, mo/day/yr sample was		
submitted		Water Well Disinfected?		Yes <input checked="" type="checkbox"/>	No	

5	TYPE OF CASING USED:		5 Wrought iron		8 Concrete tile		CASING JOINTS:		Glued		Clamped	
	1 Steel	3 RMP (SR)	6 Asbestos-Cement		9 Other (Specify below)				Welded			
	2 PVC	4 ABS	7 Fiberglass						Threaded			
	Blank casing Diameter 1 1/4 in. to		ft., Dia		in. to		ft., Dia		in. to		ft.	
	Casing height below land surface 60 in.,		weight		lbs. / ft.		Wall thickness or gauge No.					
	TYPE OF SCREEN OR PERFORATION MATERIAL:				7 PVC		10 Asbestos-cement					
	1 Steel	3 Stainless Steel	5 Fiberglass		8 RMP (SR)		11 other (specify)		N/A			
	2 Brass	4 Galvanized steel	6 Concrete tile		9 ABS		12 None used (open hole)					
	SCREEN OR PERFORATION OPENING ARE:		5 Gauzed wrapped				8 Saw cut		11 None (open hole)			
	1 Continuous slot	3 Mill slot	6 Wire wrapped				9 Drilled holes					
	2 Louvered shutter	4 Key punched	7 Torch cut				10 Other (specify)		N/A			
	SCREEN-PERFORATION INTERVALS:		from		ft. to		ft., From		ft. to		ft.	
			from		ft. to		ft., From		ft. to		ft.	
	GRAVEL PACK INTERVALS:		from		ft. to		ft., From		ft. to		ft.	
			from		ft. to		ft., From		ft. to		ft.	

6 GROUT MATERIAL:		1 Neat cement	2 Cement grout	3 Bentonite	4 Other
Grout Intervals: From 1		ft. to 14.5	ft. From	ft. to	ft. From
What is the nearest source of possible contamination:					
1 Septic tank	4 Lateral lines	7 Pit privy	10 Livestock pens	14 Abandon water well	
2 Sewer lines	5 Cess pool	8 Sewage lagoon	11 Fuel storage	15 Oil well/Gas well	
3 Watertight sewer lines	6 Seepage pit	9 Feedyard	12 Fertilizer storage	16 Other (specify below)	
			13 Insecticide storage	None Apparent	

<b>Direction from well?</b>	<b>How many feet?</b>
-----------------------------	-----------------------

[illegible]

7. **CONTRACTOR'S OR LANDOWNER'S CERTIFICATION:** This water well was (1) constructed, (2) reconstructed, or (3) plugged under my jurisdiction and was completed on (mo/day/year) 07/20/1995 and this record is true to the best of my knowledge and belief. Kansas Water Well Contractor's License No. 236 This Water Well Record was completed on (mo/day/yr) 07/21/95 Under the business name of Harp Well & Pump Service, Inc by (signature)

Jane Frederick