

PTW-1 2311006

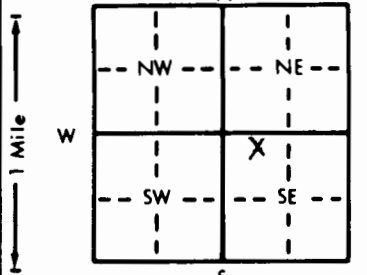
WATER WELL RECORD Form WWC-5 KSA 82a-1212

1 LOCATION OF WATER WELL: County: <u>Sedgwick</u>	Fraction <u>NE 1/4 NW 1/4 SE 1/4</u>	Section Number <u>21</u>	Township Number <u>T 27 S</u>	Range Number <u>R 1 E</u>
--	---	-----------------------------	----------------------------------	------------------------------

Distance and direction from nearest town or city street address of well if located within city?

N.E. crn. Laura & English Wichita

2 WATER WELL OWNER: RR#, St. Address, Box # : City, State, ZIP Code :	<u>City of Wichita</u> <u>1900 E 9th N</u> <u>Wichita KS 67214</u>	Board of Agriculture, Division of Water Resources Application Number:
---	--	--

3 LOCATE WELL'S LOCATION WITH AN "X" IN SECTION BOX: 	4 DEPTH OF COMPLETED WELL: <u>28.5</u> ft. ELEVATION: Depth(s) Groundwater Encountered 1. <u>14.0</u> ft. 2. <u>14.0</u> ft. 3. <u>14.0</u> ft. WELL'S STATIC WATER LEVEL <u>12.chemical/bacteriological sample submitted to Department? Yes <u>X</u> No <u>X</u> ; If yes, mo/day/yr sample was submitted Water Well Disinfected? Yes <u>X</u> No <u>X</u>
--	---

wrapped</u> 5 Gauzed wrapped 8 Saw cut 11 None (open hole) 2 Louvered shutter 4 Key punched 7 Torch cut 9 Drilled holes SCREEN-PERFORATED INTERVALS: From <u>16.0</u> ft. to <u>28.2</u> ft. From <u>16.0</u> ft. to <u>28.2</u> ft. From <u>16.0</u> ft. to <u>28.2</u> ft. GRAVEL PACK INTERVALS: From <u>13.0</u> ft. to <u>28.5</u> ft. From <u>13.0</u> ft. to <u>28.5</u> ft. From <u>13.0</u> ft. to <u>28.5</u> ft.

6 GROUT MATERIAL: 1 Neat cement 2 Cement grout 3 Bentonite 4 Other Grout Intervals: From <u>0.0</u> ft. to <u>6.0</u> ft. From <u>6.0</u> ft. to <u>7.5</u> ft. From <u>7.5</u> ft. to <u>7.5</u> ft. What is the nearest source of possible contamination: 1 Septic tank 4 Lateral lines 7 Pit privy 10 Livestock pens 14 Abandoned water well 2 Sewer lines 5 Cess pool 8 Sewage lagoon 11 Fuel storage 15 Oil well/Gas well 3 Watertight sewer lines 6 Seepage pit 9 Feedyard 12 Fertilizer storage 16 Other (specify below) 13 Insecticide storage Direction from well? How many feet?

FROM	TO	LITHOLOGIC LOG	FROM	TO	PLUGGING INTERVALS
0.0	3.8	Silty Clay, tr. sand			
3.8	5.0	Silty Clay			
5.0	7.0	Silt, v. sand			
7.0	10.3	Interbeds of Sand, tr. FeO			
10.3	12.0	f-vf Sand			
12.0	15.7	m Sand			
15.7	15.9	m-f Silty Sand			
15.9	18.8	vc Sand			
18.8	23.0	Gravel			
23.0	23.6	Decreasing Gravel			
23.6	24.8	m-f Sand			
24.8	30.0	Claystone			

Allison Irwin contacted Don Taylor on 6-20-95 for an extension on completing these forms.

7 CONTRACTOR'S OR LANDOWNER'S CERTIFICATION: This water well was (1) constructed (2) reconstructed, or (3) plugged under my jurisdiction and was completed on (mo/day/year) <u>7-9-95</u> and this record is true to the best of my knowledge and belief. Kansas Water Well Contractor's License No. <u>531</u> This Water Well Record was completed on (mo/day/yr) <u>8-17-95</u> under the business name of <u>GSI</u> by (signature) <u>Allison Irwin</u>
--

INSTRUCTIONS: Use typewriter or ball point pen. PLEASE PRESS FIRMLY and PRINT clearly. Please fill in blanks, underline or circle the correct answers. Send top three copies to Kansas Department of Health and Environment, Bureau of Water, Topeka, Kansas 66620-0001. Telephone: 913-296-5545. Send one to WATER WELL OWNER and retain one for your records.