


1 LOCATION OF WATER WELL: County: Sedgwick Fraction: SE 1/4 SE 1/4 SW 1/4 Section Number: 21 Township Number: T 27 S Range Number: R 10 E/W

Distance and direction from nearest town or city street address of well if located within city? Between Mead & Mosley, just N of Hwy 54/Kellogg

2 WATER WELL OWNER: RR#, St. Address, Box #: City, State, ZIP Code: Board of Agriculture, Division of Water Resources Application Number:

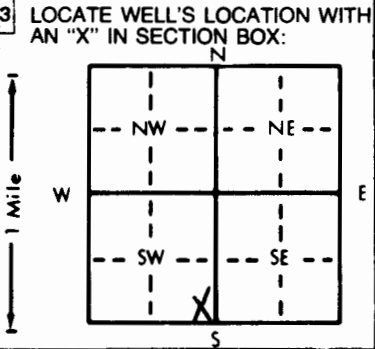

3 LOCATE WELL'S LOCATION WITH AN 'X' IN SECTION BOX: 4 DEPTH OF COMPLETED WELL: 23.6 ft. ELEVATION: 1289.99. WELL'S STATIC WATER LEVEL: 16.85 ft. below land surface measured on mo/day/yr: 8-31-95.

5 TYPE OF BLANK CASING USED: 1 Steel, 2 PVC, 3 RMP (SR), 4 ABS, 5 Wrought iron, 6 Asbestos-Cement, 7 Fiberglass, 8 Concrete tile, 9 Other (specify below), 10 Asbestos-cement, 11 Injection well, 12 Other (Specify below): Extraction Well.

TYPE OF SCREEN OR PERFORATION MATERIAL: 1 Steel, 2 Brass, 3 Stainless steel, 4 Galvanized steel, 5 Fiberglass, 6 Concrete tile, 7 PVC, 8 RMP (SR), 9 ABS, 10 Asbestos-cement, 11 Other (specify), 12 None used (open hole).

6 GROUT MATERIAL: 1 Neat cement, 2 Cement grout, 3 Bentonite, 4 Other. Grout Intervals: From 0.0 ft. to 10.5 ft., From 10.5 ft. to 12.5 ft.

Table with columns: FROM, TO, LITHOLOGIC LOG, FROM, TO, PLUGGING INTERVALS. Rows describe soil layers from 0 to 24 feet depth.

7 CONTRACTOR'S OR LANDOWNER'S CERTIFICATION: This water well was (1) constructed, (2) reconstructed, or (3) plugged under my jurisdiction and was completed on (mo/day/year) 8-31-95 and this record is true to the best of my knowledge and belief. Kansas Water Well Contractor's License No. 531. This Water Well Record was completed on (mo/day/yr) 9-30-95 under the business name of GST by signature Allison Juvin.

OFFICE USE ONLY T R E/W SEC. 1/4 1/4 1/4