


**270' East & 30' South of centerline of Mosley & 19**

Board of Agriculture, Division of Water Resources  
Application Number:

submitted Water Well Disinfected? Yes No ☒

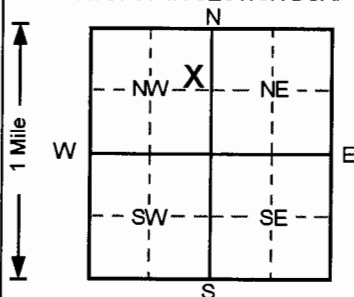

How many feet?

FROM	TO	LITHOLOGIC LOG	FROM	TO	PLUGGING INTERVALS
0	4	Clay, Dark Brown			
4	15	Sand, Light Brown			
15	35	Sand, Light Brown			
35	40	Shale, Dark Gray			
					RW3 , Tag # 00113845 , Flushmount
					Project Name: Security Oil
					GeoCore # 222 . KDHE # U2 087 421

INSTRUCTIONS: Use typewriter or ball point pen. PLEASE PRESS FIRMLY and PRINT clearly. Please fill in blanks, underline or circle the correct answers. Send top three copies to Kansas Department of Health and Environment, Bureau of Water, Topeka, Kansas 66620-0001. Telephone: 913-296-5545. Send one to WATER WELL OWNER and retain one for your records.