

MW-2 B 211073

WATER WELL RECORD

Form WWC-5

KSA 82a-1212

1 LOCATION OF WATER WELL:	Fraction	Section Number	Township Number	Range Number
County: <u>Sedgwick</u>	<u>SW 1/4 SE 1/4 SW 1/4</u>	<u>3</u>	T <u>27</u> S	R <u>1</u> E/W

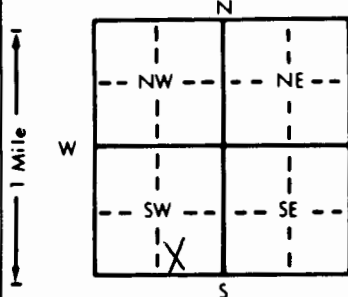
Distance and direction from nearest town or city street address of well if located within city?

2102 E 21st St N, Wichita

2 WATER WELL OWNER:	Board of Agriculture, Division of Water Resources
RR#, St. Address, Box # :	Application Number:
City, State, ZIP Code :	

Coastal Remediation CorpPO Box 1030Wichita KS 67201-10-30

3 LOCATE WELL'S LOCATION WITH AN "X" IN SECTION BOX:	4 DEPTH OF COMPLETED WELL: <u>23</u> ft. ELEVATION:
--	---


WELL WATER TO BE USED AS:

1 Domestic 3 Feedlot 6 Oil field water supply 9 Dewatering 12 Other (Specify below)

2 Irrigation 4 Industrial 7 Lawn and garden only 10 Monitoring wellWas a chemical/bacteriological sample submitted to Department? Yes No X; If yes, mo/day/yr sample was submittedWater Well Disinfected? Yes No X

5 TYPE OF BLANK CASING USED:	5 Wrought iron	8 Concrete tile	CASING JOINTS: Glued <u>Flush</u> Clamped <u>Flush</u>
1 Steel	3 RMP (SR)	6 Asbestos-Cement	9 Other (specify below)
<u>2 PVC</u>	4 ABS	7 Fiberglass	<u>Threaded</u> <u>Flush</u>


TYPE OF SCREEN OR PERFORATION MATERIAL:	10 Asbestos-cement
1 Steel	8 RMP (SR)
3 Stainless steel	11 Other (specify)
2 Brass	12 None used (open hole)
4 Galvanized steel	
6 Concrete tile	
9 ABS	

SCREEN OR PERFORATION OPENINGS ARE:

1 Continuous slot 3 Mill slot 5 Gauzed wrapped 8 Saw cut 11 None (open hole)

2 Louvered shutter 4 Key punched 6 Wire wrapped 9 Drilled holes 10 Other (specify)



7 CONTRACTOR'S OR LANDOWNER'S CERTIFICATION: This water well was <u>(1) constructed</u> , <u>(2) reconstructed</u> , or <u>(3) plugged</u> under my jurisdiction and was completed on (mo/day/year) <u>11-7-95</u> and this record is true to the best of my knowledge and belief. Kansas Water Well Contractor's License No. <u>531</u> This Water Well Record was completed on (mo/day/yr) <u>11-27-95</u> under the business name of <u>GSI</u> by (signature) <u>Allison J. J. J.</u>

INSTRUCTIONS: Use typewriter or ball point pen. PLEASE PRESS FIRMLY and PRINT clearly. Please fill in blanks, underline or circle the correct answers. Send top three copies to Kansas Department of Health and Environment, Bureau of Water, Topeka, Kansas 66620-0001. Telephone: 913-296-5545. Send one to WATER WELL OWNER and retain one for your records.